


# T. 38 S., R. 7 W., W. M.

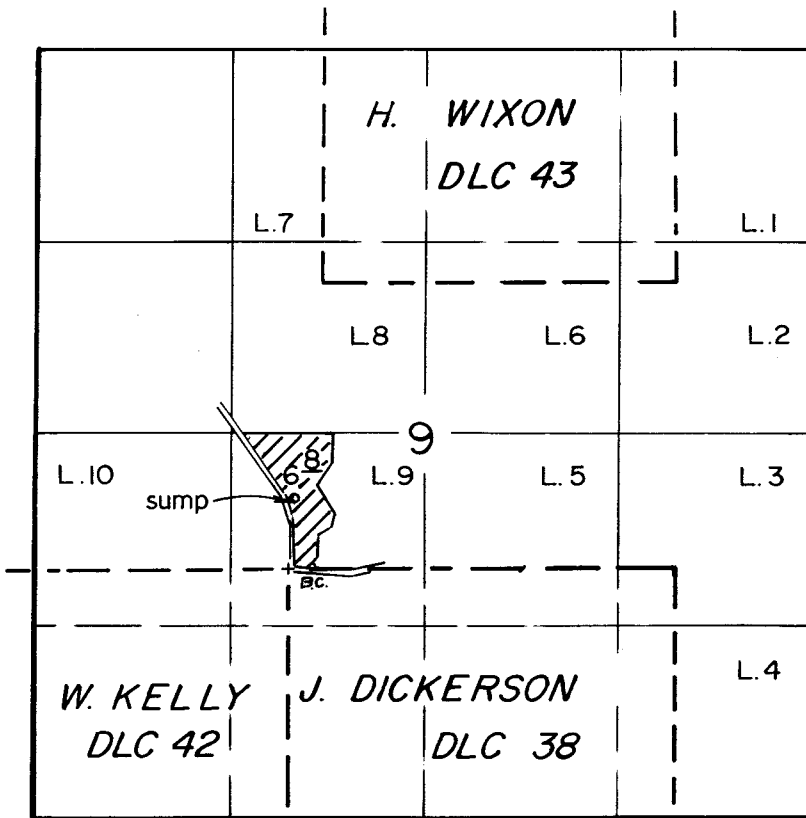

sump location: 480' N. & 50' E. from NW cor., DLC 38

Scale: 1" = 1320'

## FINAL PROOF SURVEY UNDER

Application No. G-8123 Permit No. G-7500.  
IN NAME OF

LESLIE R. & PATRICIA A. FROST

Surveyed OCT. 27. 1983, by B. S. JAMES