



N.W. CORNER J.S. KENDALL DONATION LAND CLAIM NO. 48

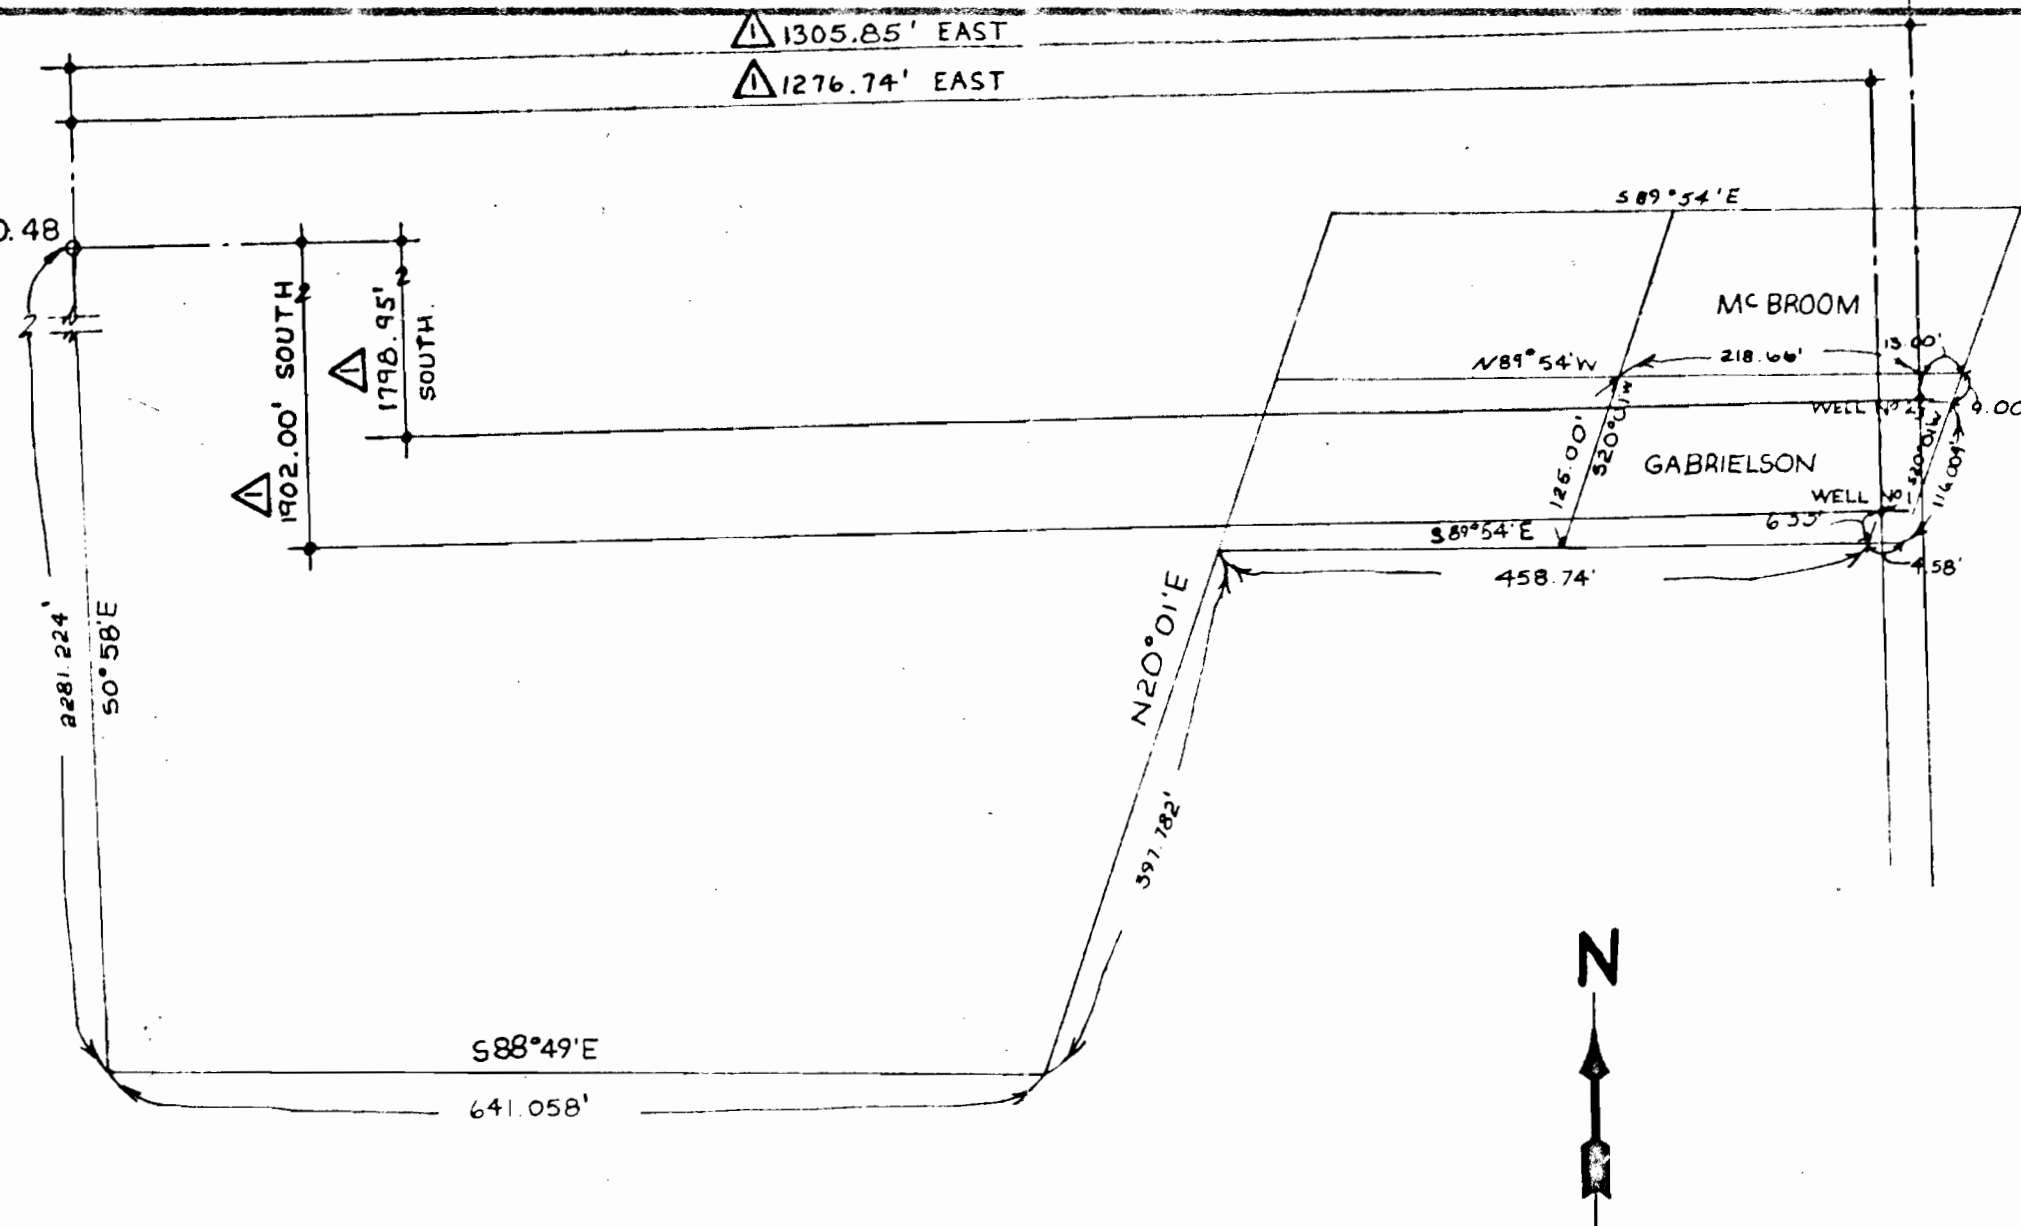

WELL LOCATION MAP

SCALE: 1/2" = ONE CHAIN

Application No. G 8058  
Permit No. G 7578

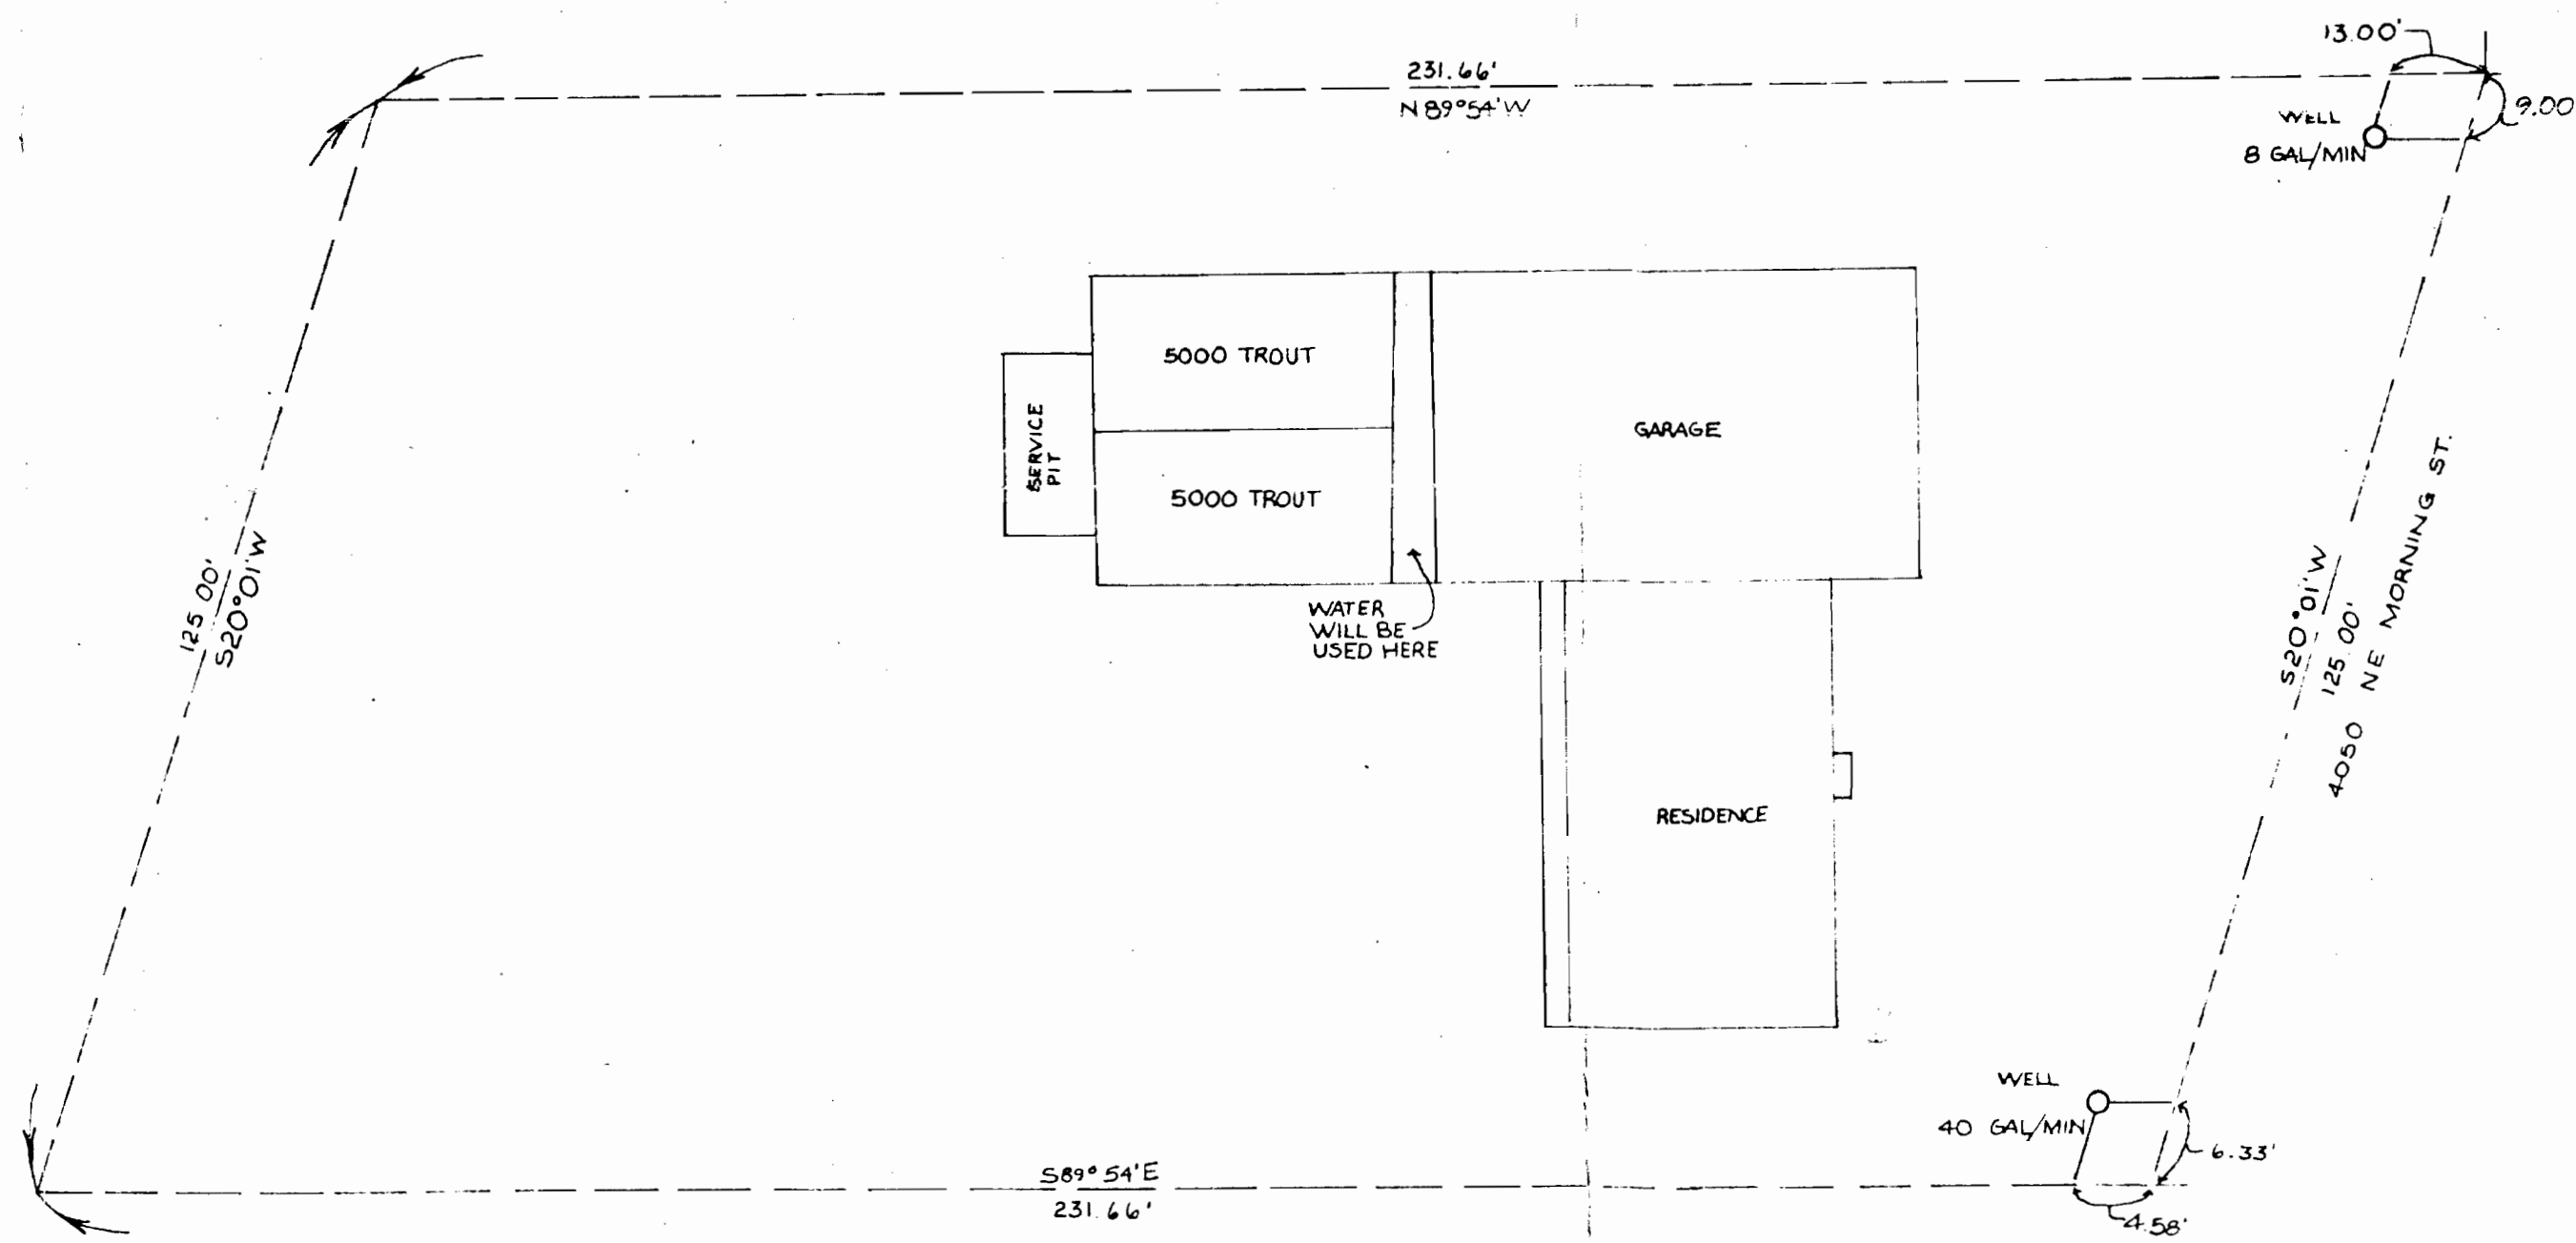

SITE PLAN

SCALE: 1" = 20'

LOT .67 ACRES

LOCATED WITHIN: SW 1/4 NE 1/4 SEC. 19 T11 S R4W WM  
BENTON COUNTY

REVISIONS	BY
△ DIMENSIONS 8-18-77	Rw

WATER WELL LOCATION MAP  
FOR MR. SIGVARD GABRIELSON

752-1952

K2W ASSOCIATES  
DESIGNERS

765 NW 5TH ST. CORVALLIS, OR.

LOCATION MAP  
SITE PLAN

DATE  
APRIL 12, 1977

SCALE  
NOTED

DRAWN  
LM

JOB  
4049-W

SHEET  
1

OF  
2 SHEETS


REVISIONS	BY

WATER WELL LOCATION MAP  
FOR MR. SIGVARD GABRIELSON

**K<sub>2</sub>W ASSOCIATES**  
BUILDING DESIGN  
765 NW 5TH ST. CORVALLIS, OR. 752 - 1952

QUARTER-QUARTER SEC. LOCATION MAP
DATE AUGUST 18, 1971
SCALE NOTED
DRAWN PM
JOB 4049 W
SHEET <b>2</b> OF SHEETS

Application No. G-8058  
Permit No. G 7578

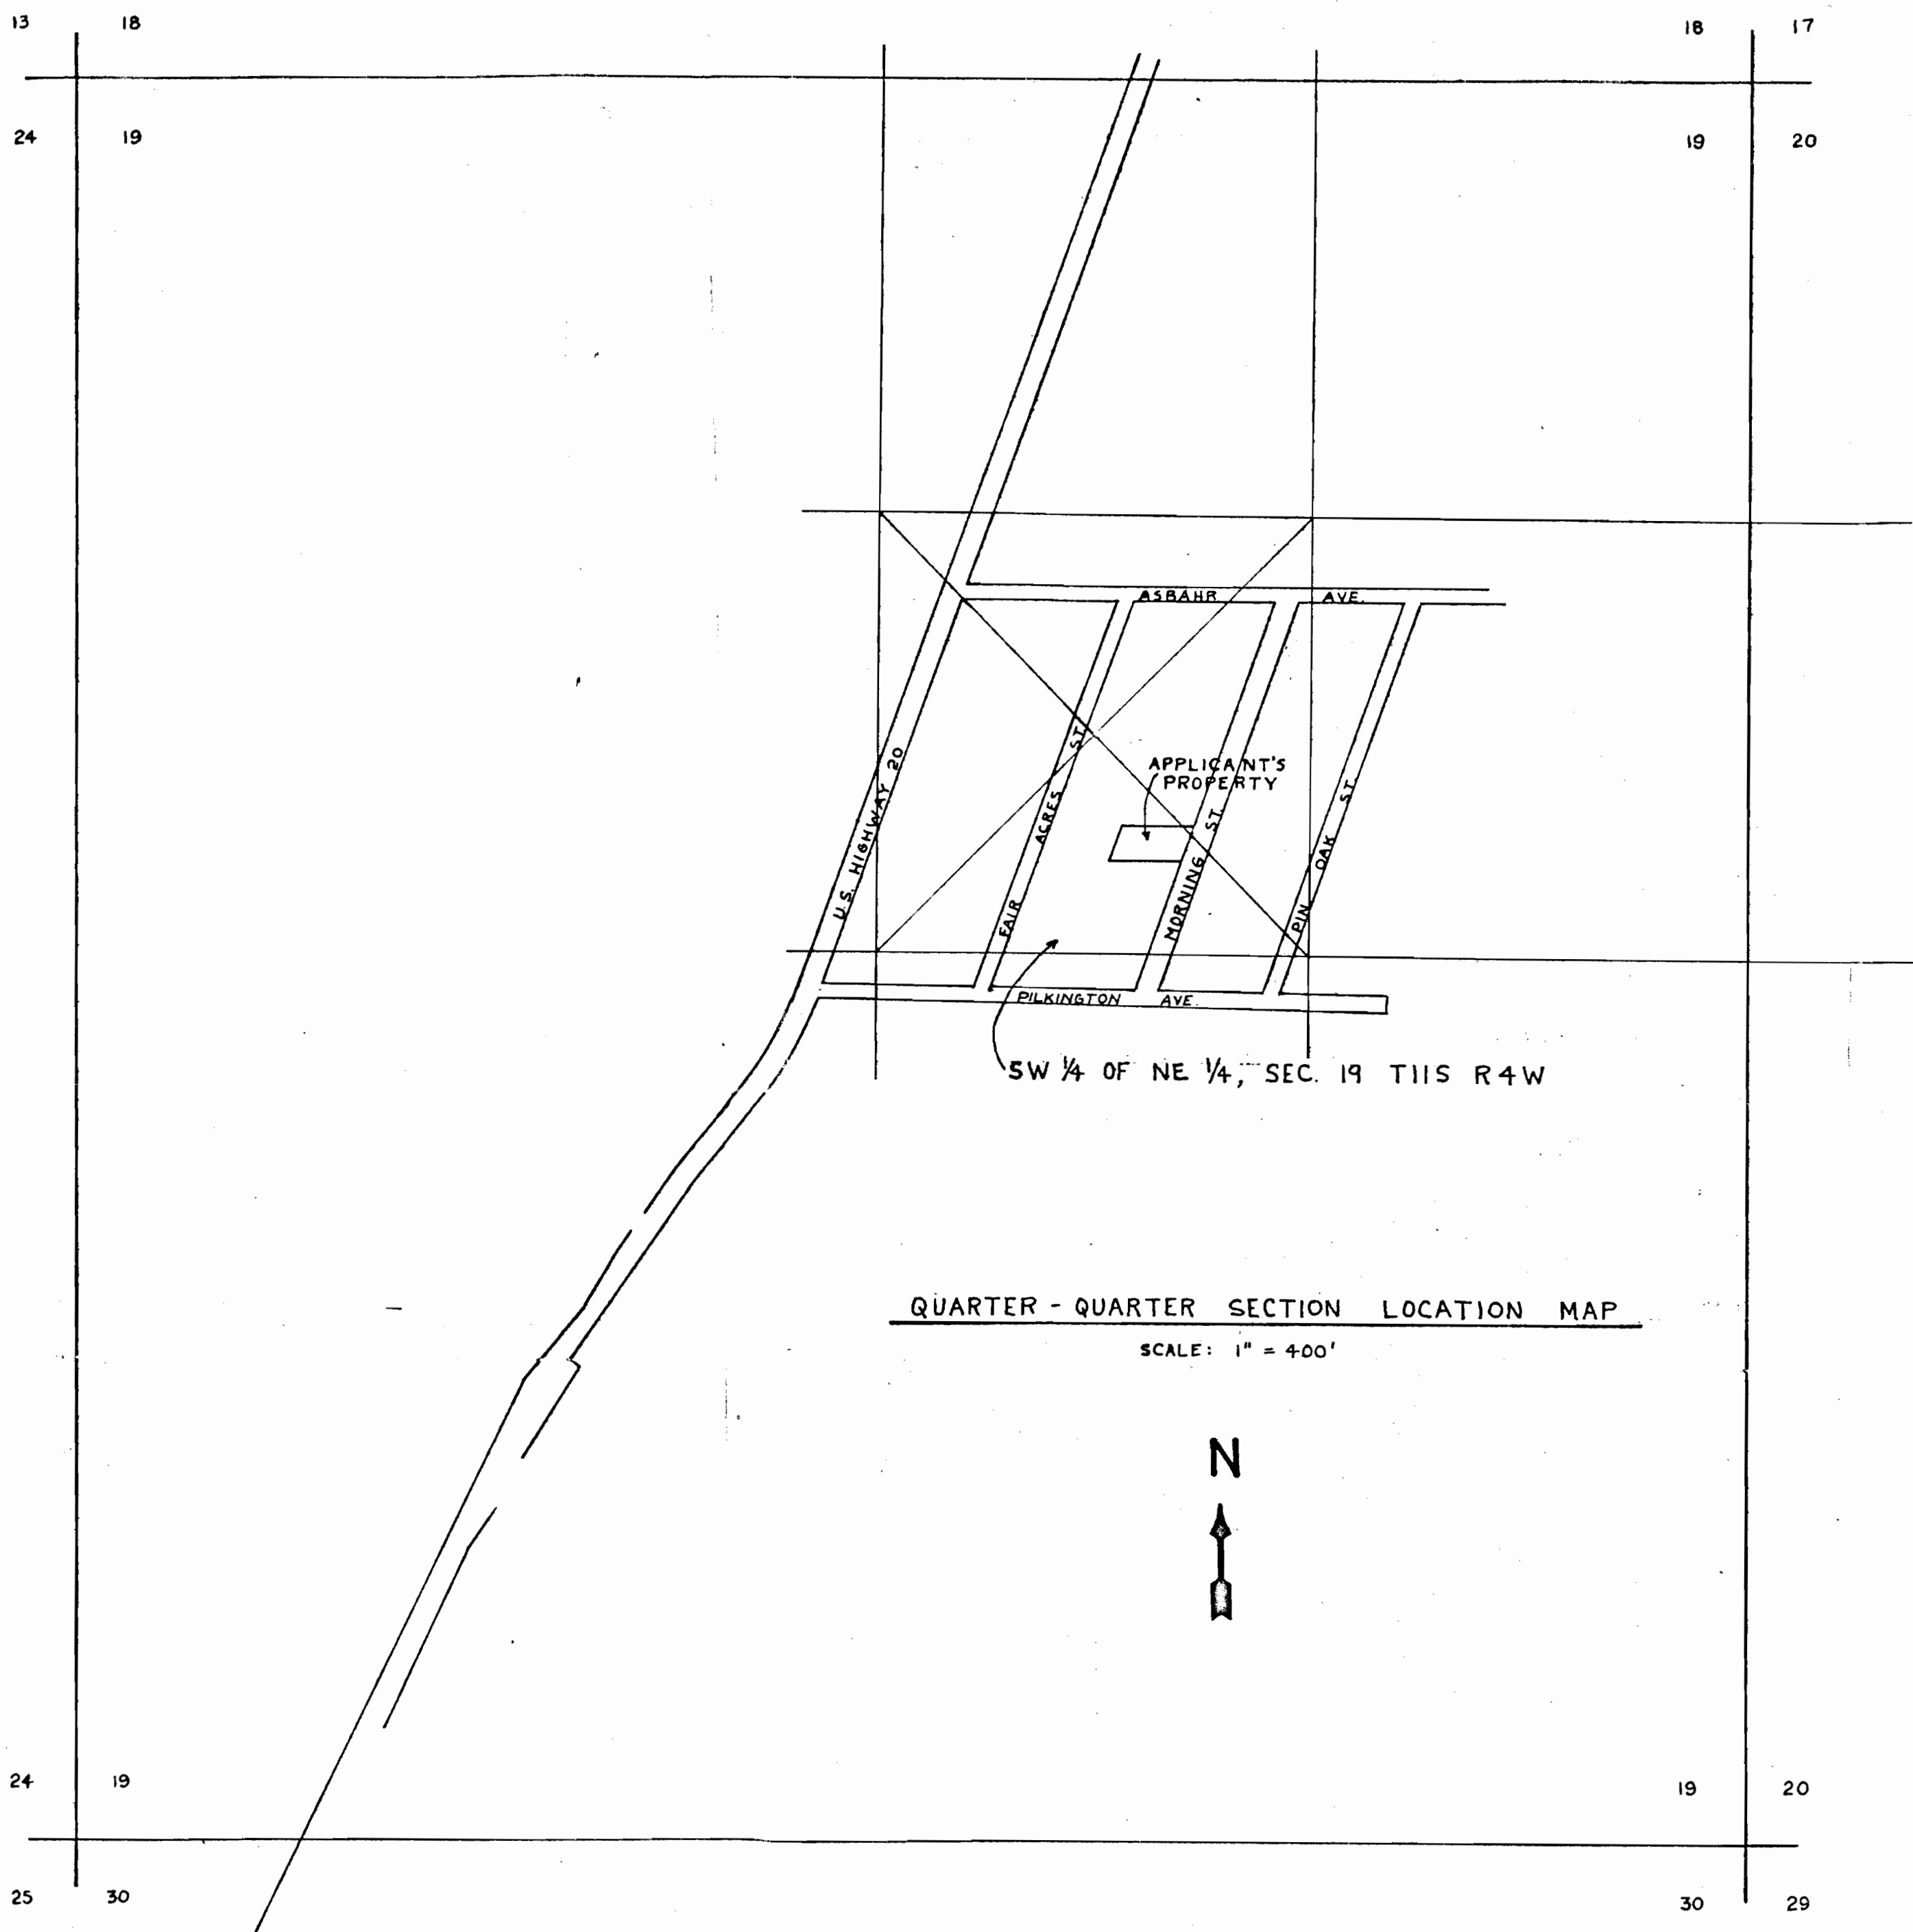

QUARTER - QUARTER SECTION LOCATION MAP  
SCALE: 1" = 400'

SW 1/4 OF NE 1/4, SEC. 19 T11S R4W

DOWPRINT CORP. 400 LITTLEFIELD AVE. 90 SAN FRANCISCO CA 94108