

RECEIVED

MAY - 9 1977

WATER RESOURCES DEPT
SALEM, OREGON

RECEIVED

MAY - 9 1977



WATER RESOURCES DEPT
SALEM, OREGON

Application No. G-8106

Permit No. G 7595

Con. Sec. 5

WHITE 4x4
TAGGED COUNTY
SURVEYOR
- IN ROCK
CAIRN

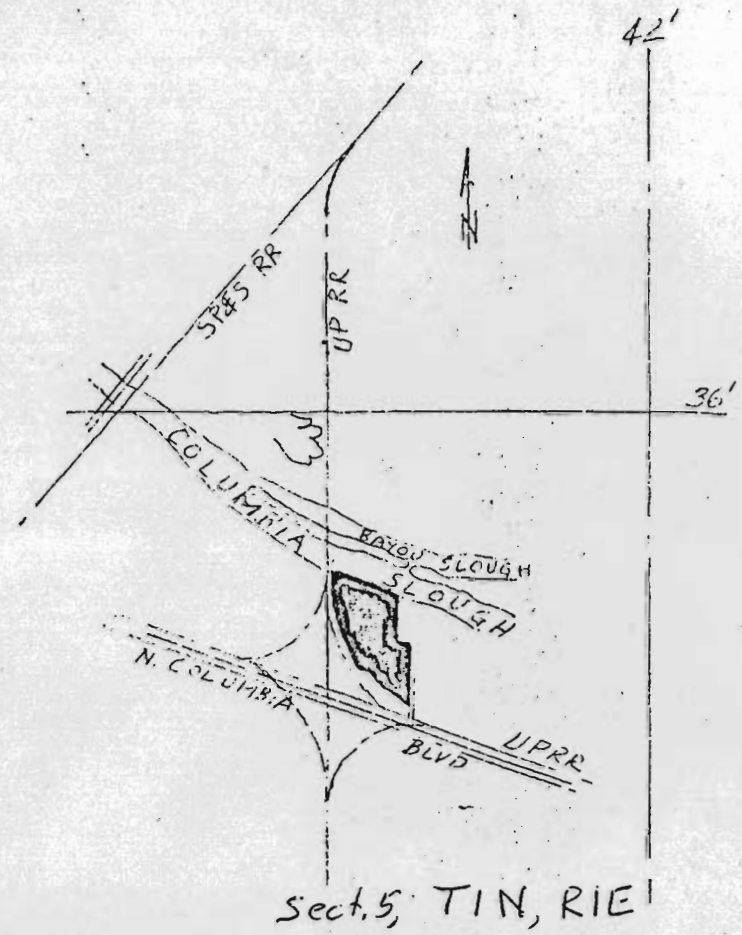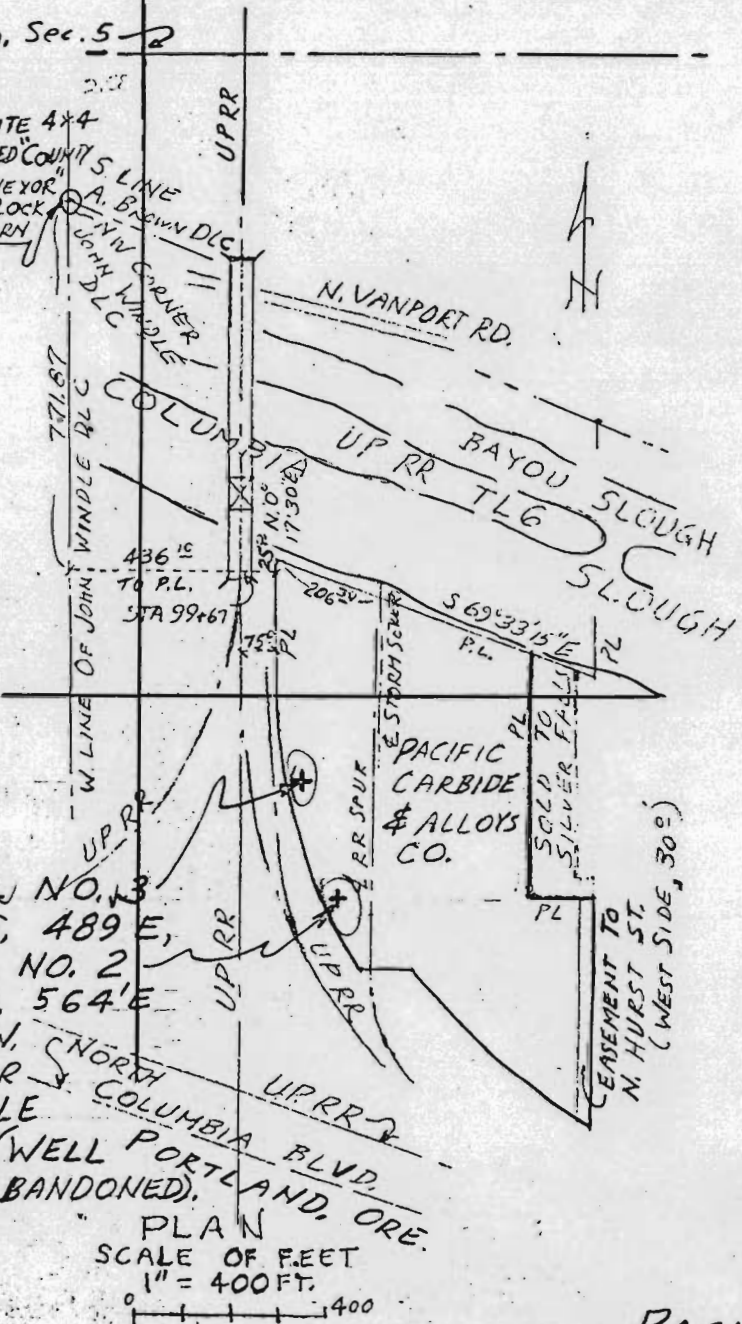

FROM USC & GS CHART 6155

PACIFIC CARBIDE & ALLOYS CO.
Box 17008, PORTLAND, OR. 97217
(503)-289-1186

C. GLOVER APRIL 19, 1977

WELL CO-ORDINATES NOT SURVEYED