



Twp 3 S Rng 38 E.W.M.

Application No. S-8174
Permit No. G 7625

RECEIVED

MAY 27 1977

WATER RESOURCES DEPT.
SALEM, OREGON

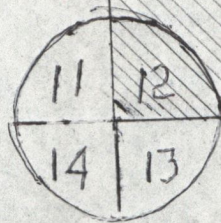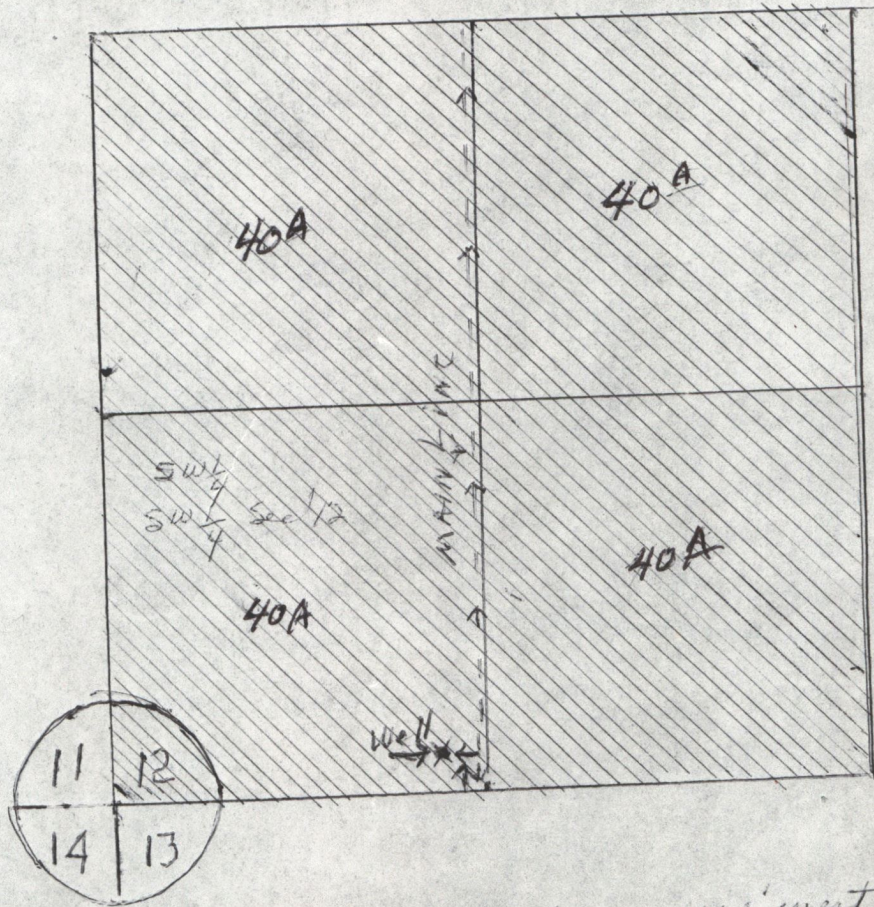

Well - 300' N + 400' west of the
SE corner of the SW 1/4 of the SW 1/4
Sec 12 Twp 3 S Rng 38 E.W.M.