


RECEIVED

JUL 5 1977

WATER RESOURCES DEPT.
SALEM, OREGON

T. 7 S., R. 2 W., W.M.

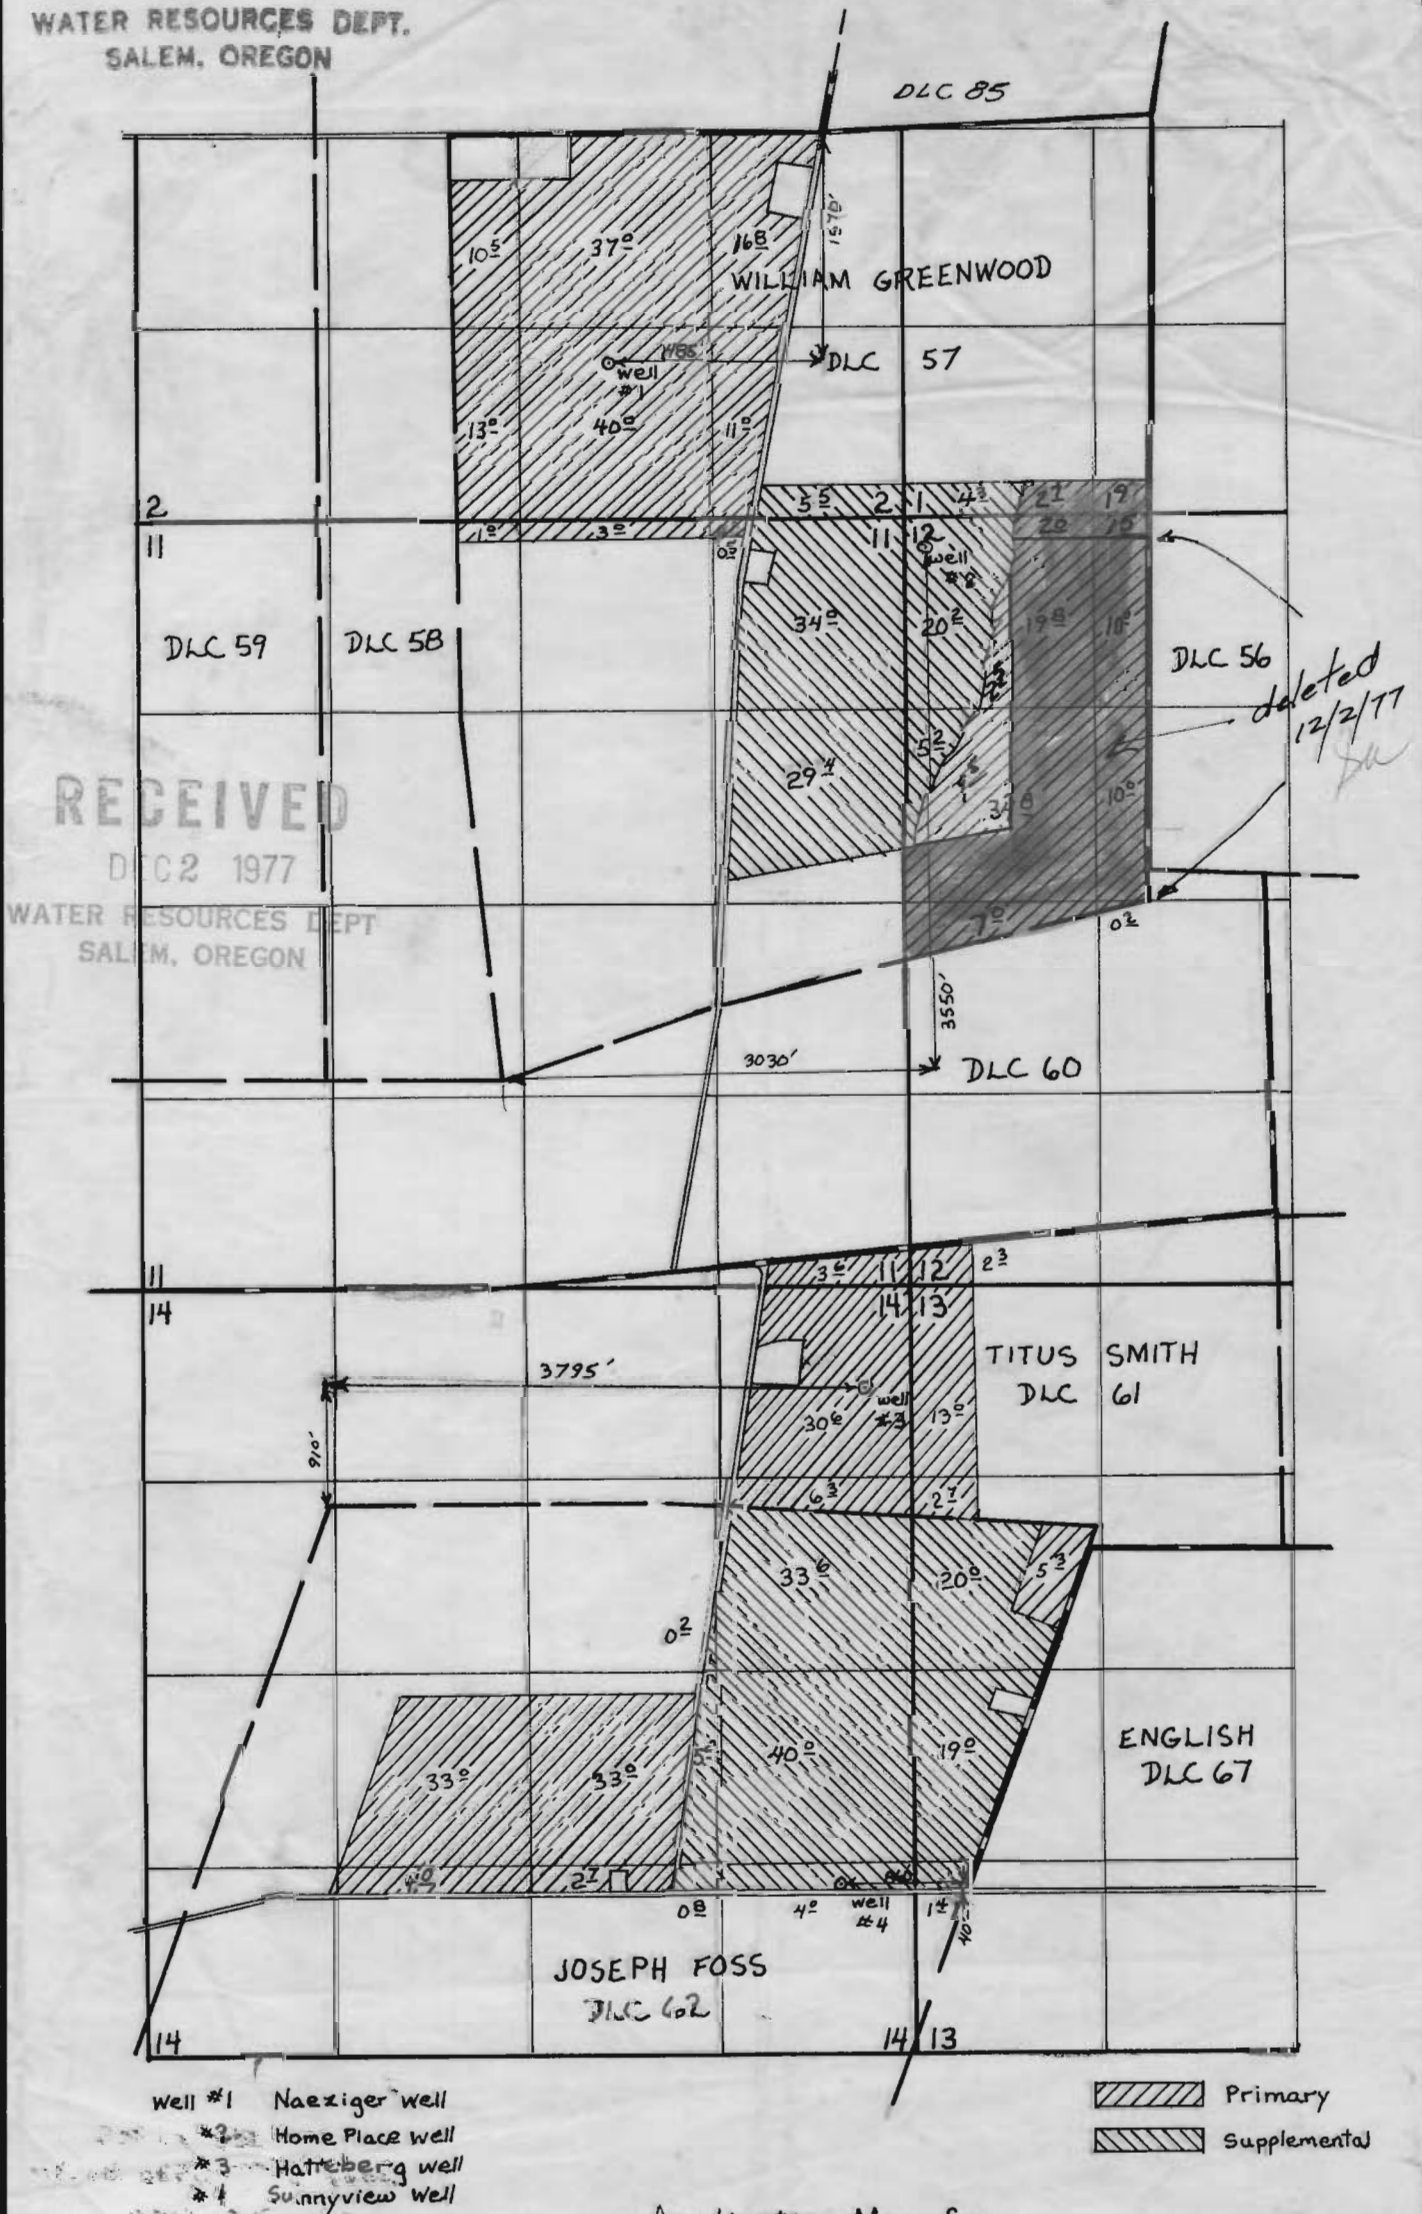

Application No. G-8007

Permit No. G 7720

Application Map for

GERALD E. ROTH