


Application No. G-1813
Permit No. G-772A

MAP OF
AREA OF WATER USAGE
CITY OF COTTAGE GROVE, OREGON

Application No. G 7813
Permit No. G 7724

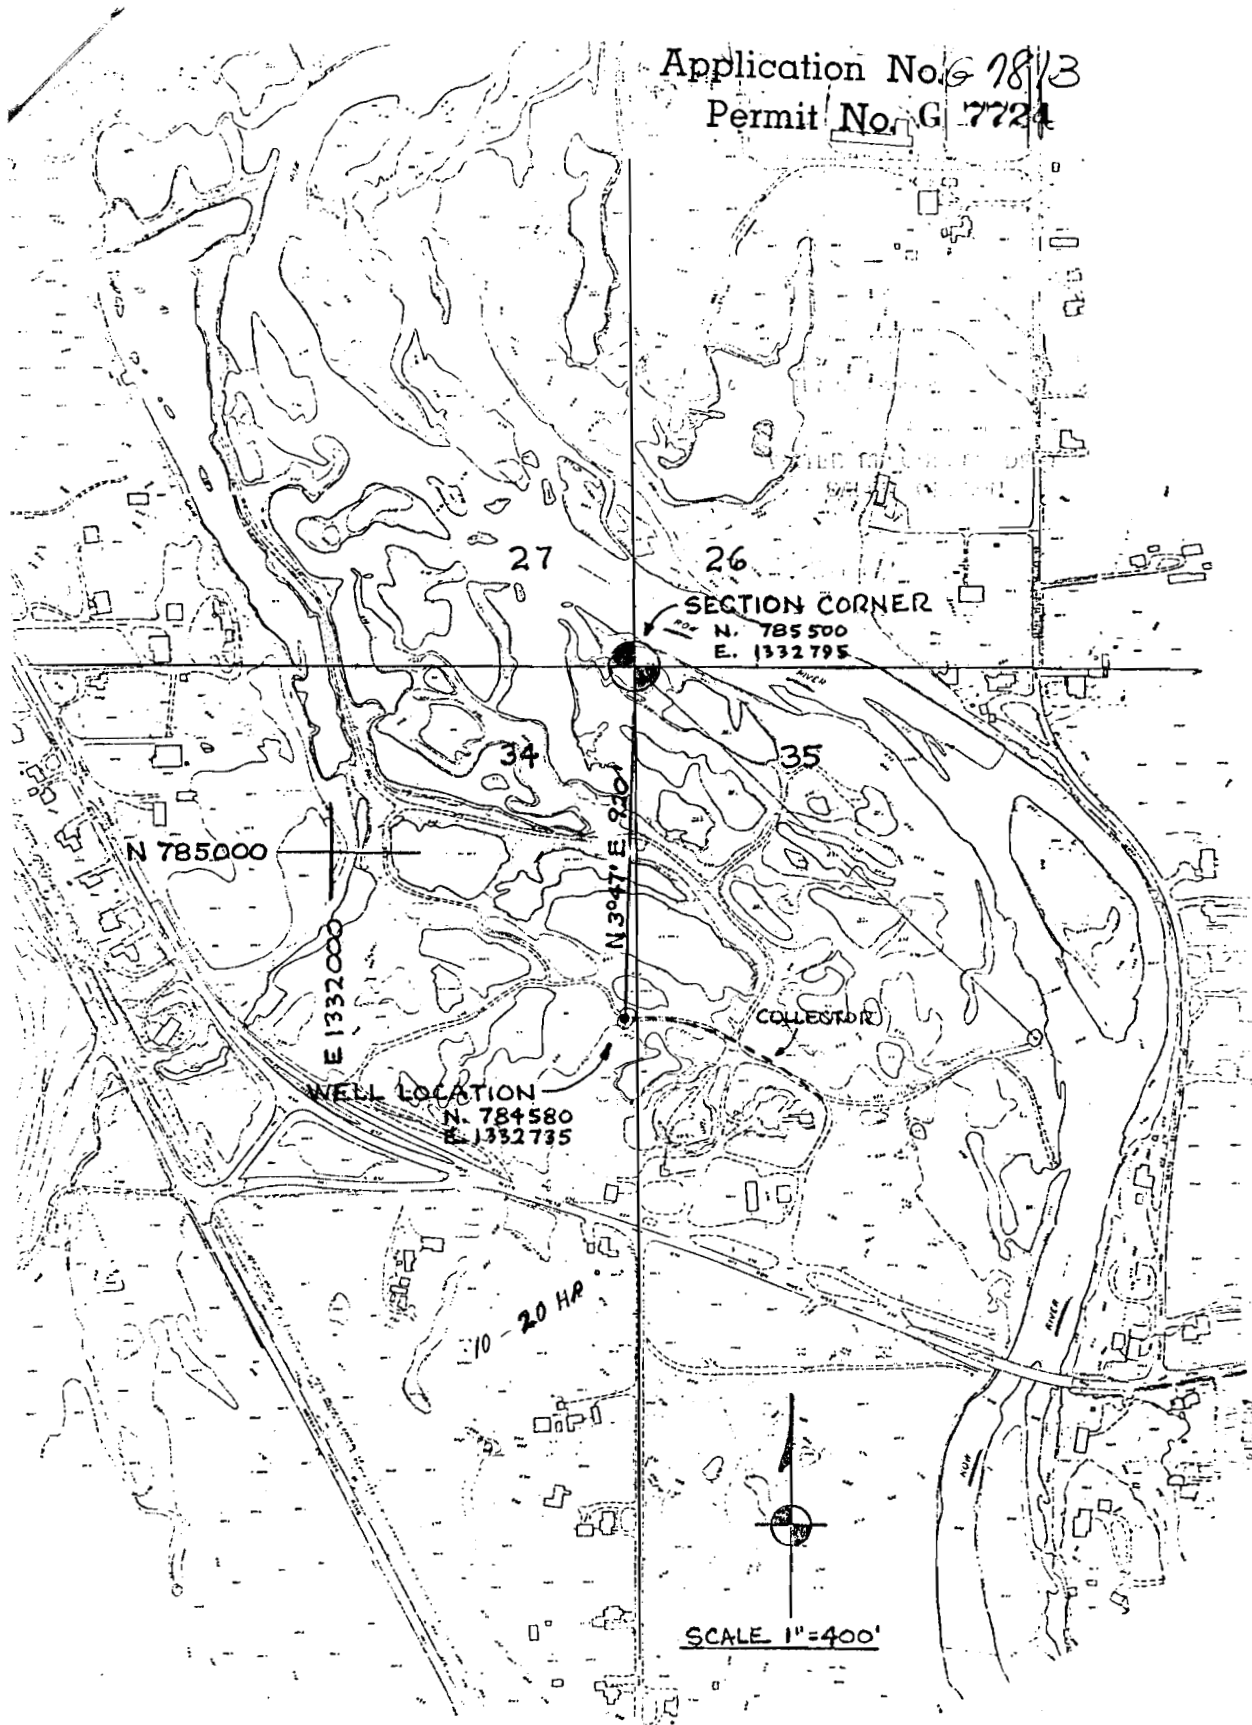

CITY OF COTTAGE GROVE
LANE COUNTY, OREGON

WELL LOCATION MAP
SECTION 34, T20S, R3W, WM.
APPLICATION NO. G-7813