


T.7S.R.4W., W.M.

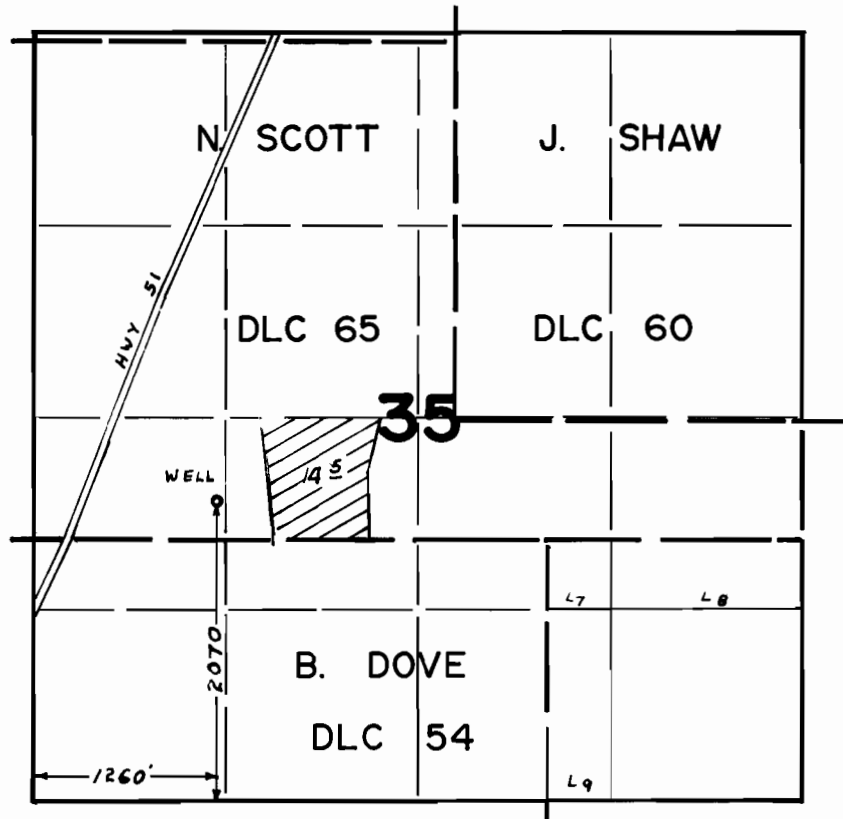

FINAL PROOF SURVEY UNDER

Application No. G-7848. Permit No. G-7725.
IN NAME OF

WALTER BROWN

Surveyed OCT. 13, 1978, by S.P. APPLGATE