


T.39S.R.35E.W.M.

Application No. G-7968
Permit No. G 7762

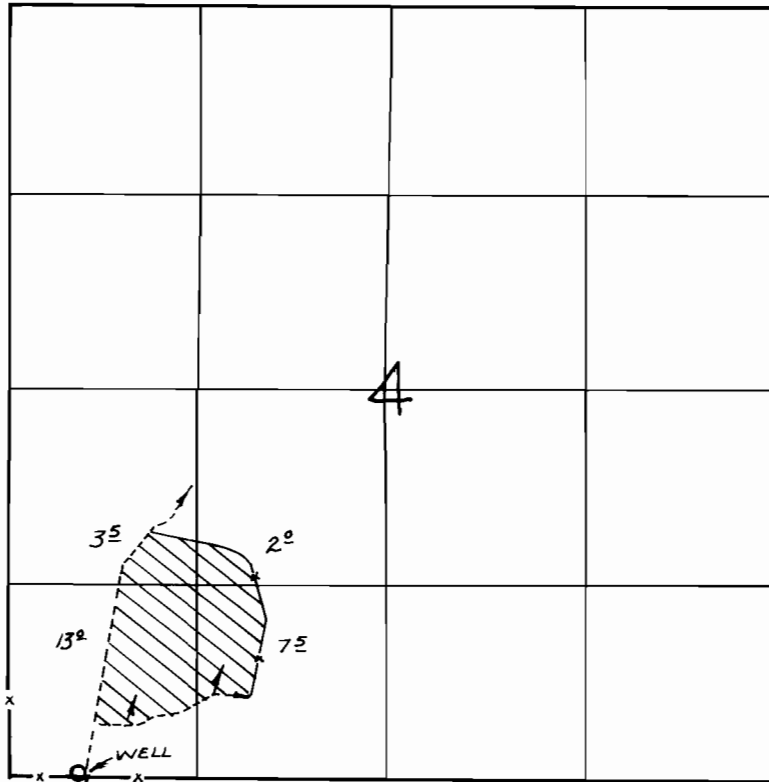

WELL LOC: 30' N' & 480' E. FROM S.W. COR. SEC. 4

FINAL PROOF SURVEY
UNDER

APPLICATION MAP FOR

Application No. _____ Permit No. _____
IN NAME OF

.....RONALD.....MCLEAN.....

Surveyed JUNE 19, 1976, by R. MUCKEY.