


T. 35S., R. 5W., W.M.

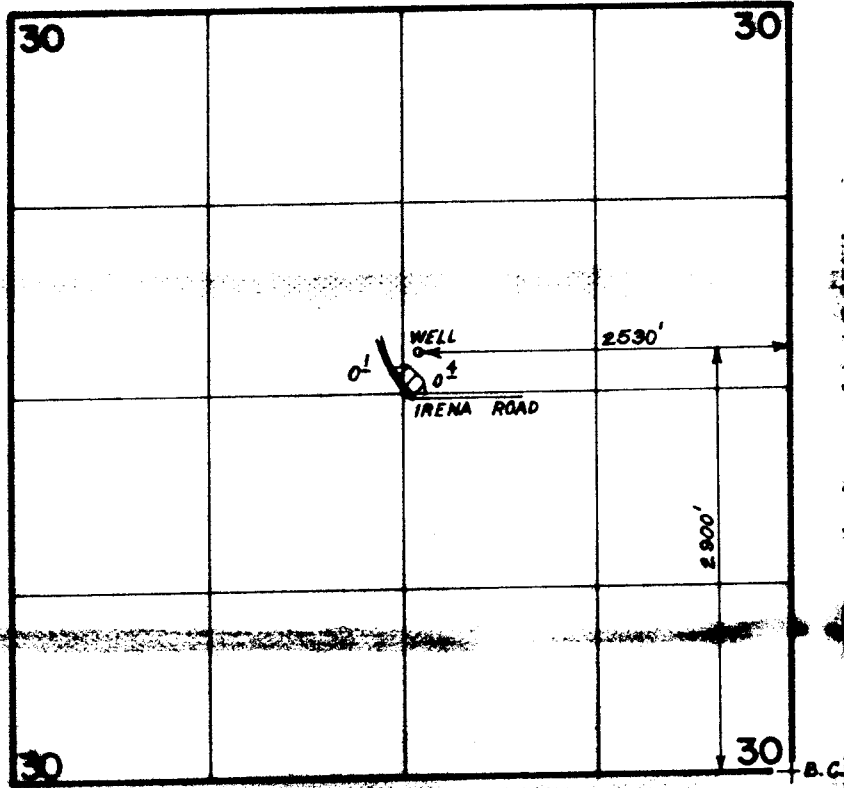

SCALE: 1" = 1320'

**FINAL PROOF SURVEY  
UNDER**

Application No. G-8411 Permit No. G-7774  
IN NAME OF

JACK R. THOMAS

Surveyed JULY 10, 1984, by B. S. JAMES

RECORDED

DEC 5 1988

WM. DIST. 14  
GRANT PAGE ONE

179-135R

TWB