


RECEIVED

JUN 27 1977

T. 1 S., R. 3 W., W.M.

WATER RESOURCES DEPT  
SALEM, OREGON

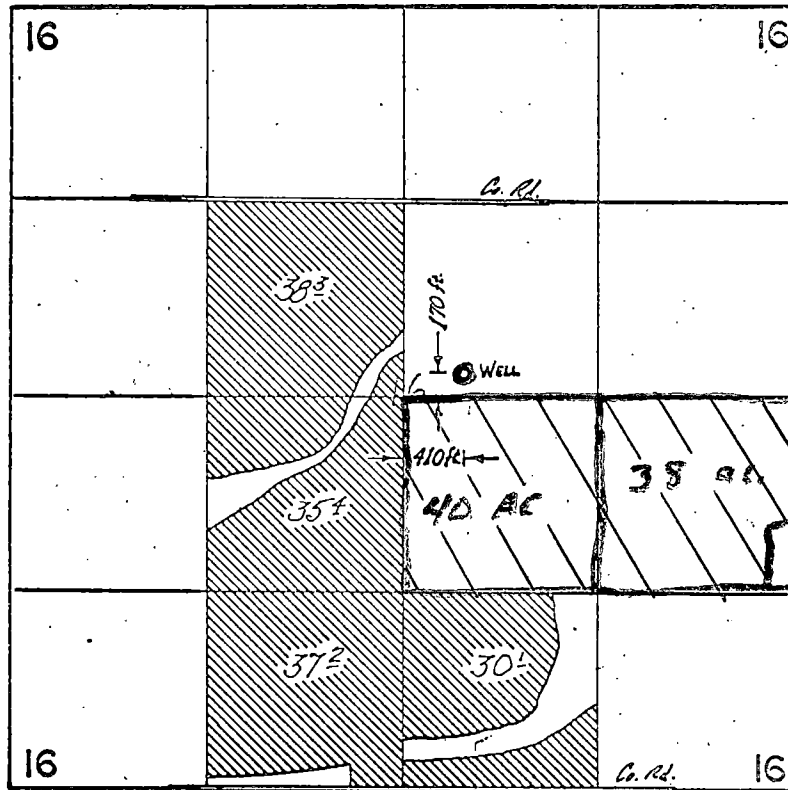

Application No. G-8238  
Permit No. G 7800

FINAL PROOF SURVEY  
UNDER

Application No. G-3690 Permit No. G-3494  
IN NAME OF

.....DONALD C. JESSE.....

Surveyed 15 JULY 1972, by D. NARBY