


T.37S., R.6 W., W.M.

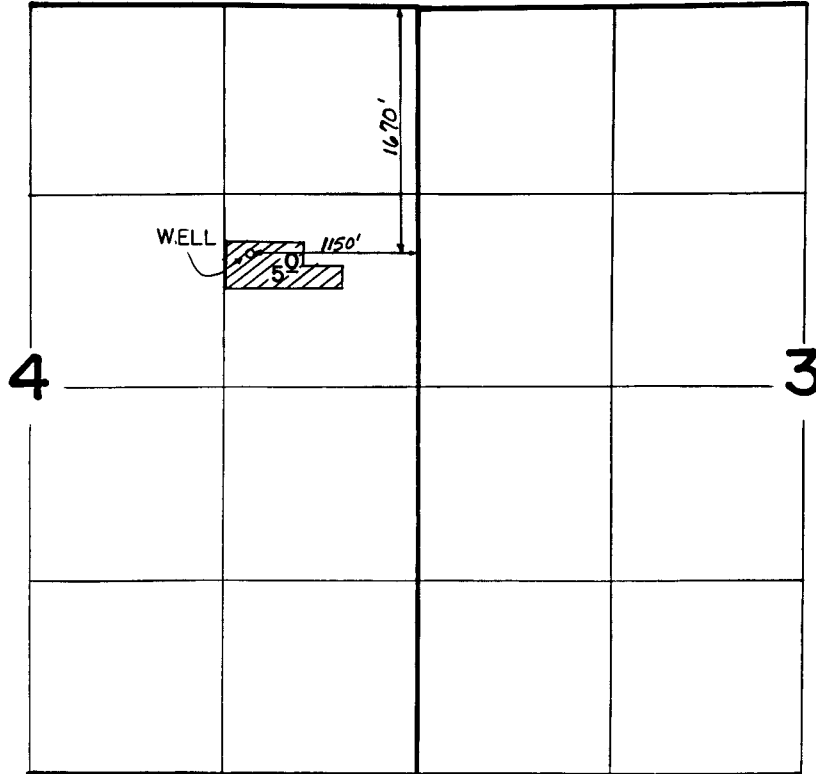

RECEIVED

FEB 02 1987

WM. DIST. 14
GRANTS PASS, ORE.

FINAL PROOF SURVEY
UNDER

Application No. G.8406 Permit No. G.7857.....
IN NAME OF

TOM E. WASHBURN

Surveyed AUG. 11, 1982., by B. S. JAMES.....

B50-39 me 25/82