


RE-ENTRANT COR. W. LINE  
AGUSTUS LAMBERT D.L.C. NO. 61



7 8  
18 17

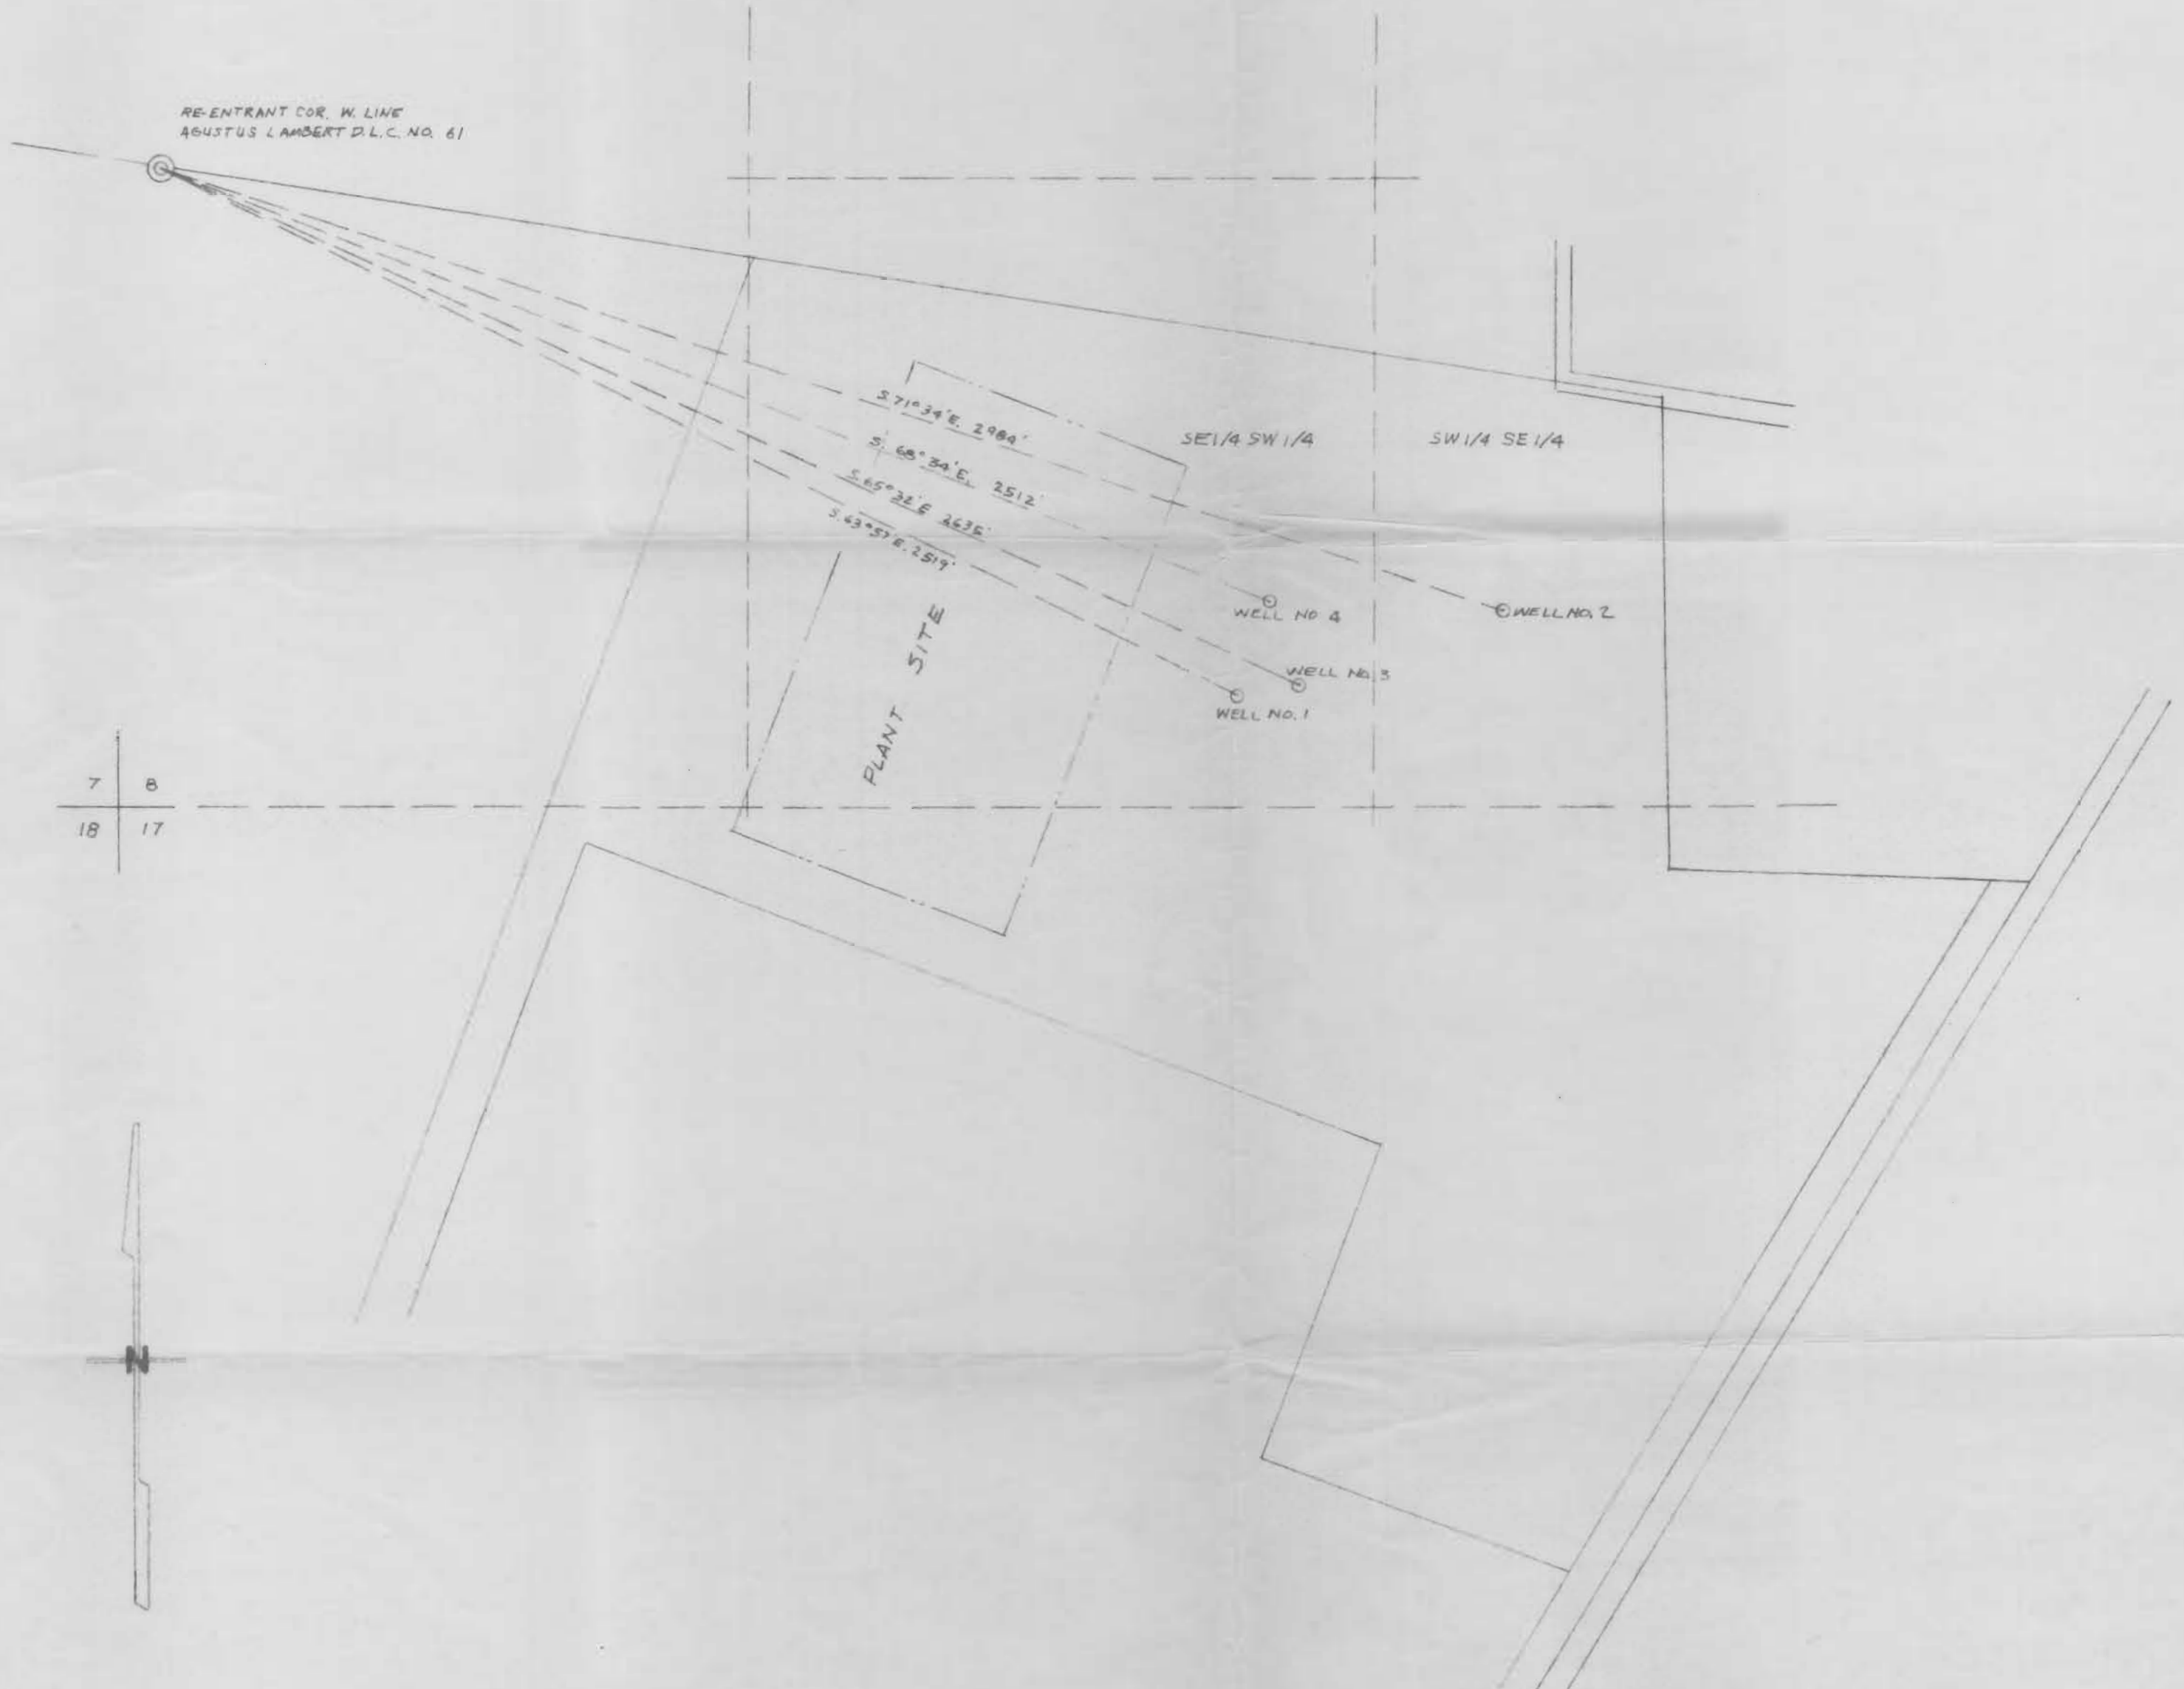

STAYTON CANNING CO. COOP  
WELL LOCATION MAP

SCALE: 1" = 300' SEC. 8 T. 6 S. R. 2 W. W.M. MARION CO. ORE.  
DEC. 12, 1977 DR. BY. COGAR

RECEIVED  
DEC 13 1977  
WATER RESOURCES DEPT  
SALEM, OREGON

Application No. G-8577  
Permit No. G 7902