


T. 4N R. 28E

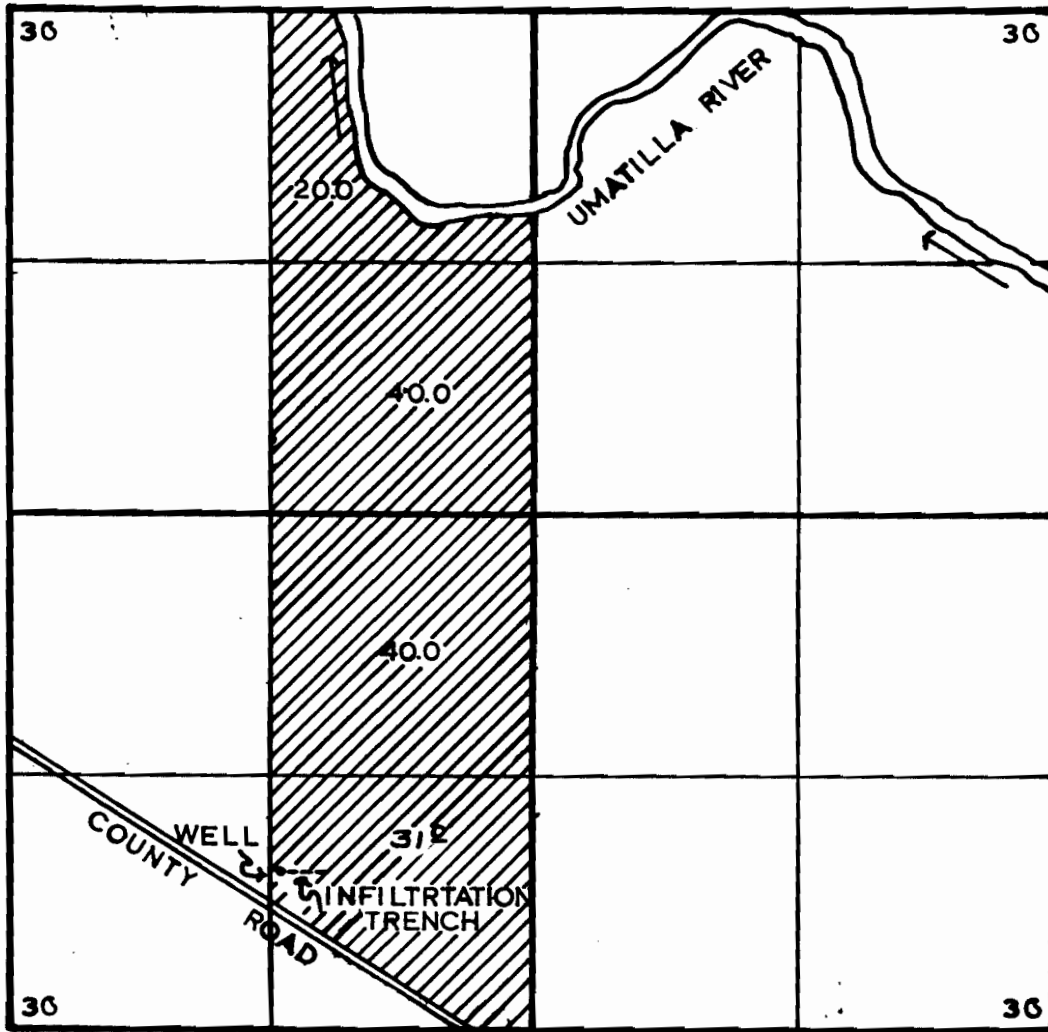

1" = 1000'

Application No. G-8574
Permit No. G 7913

WELL LOCATION

810' N. 1335' E. FROM THE
SW Cr. OF SEC 36

RECEIVED
FEB 27 1978

Frank Muller

Handwritten signature: Tony Belmont