


T. 38S., R. 5W., W.M.

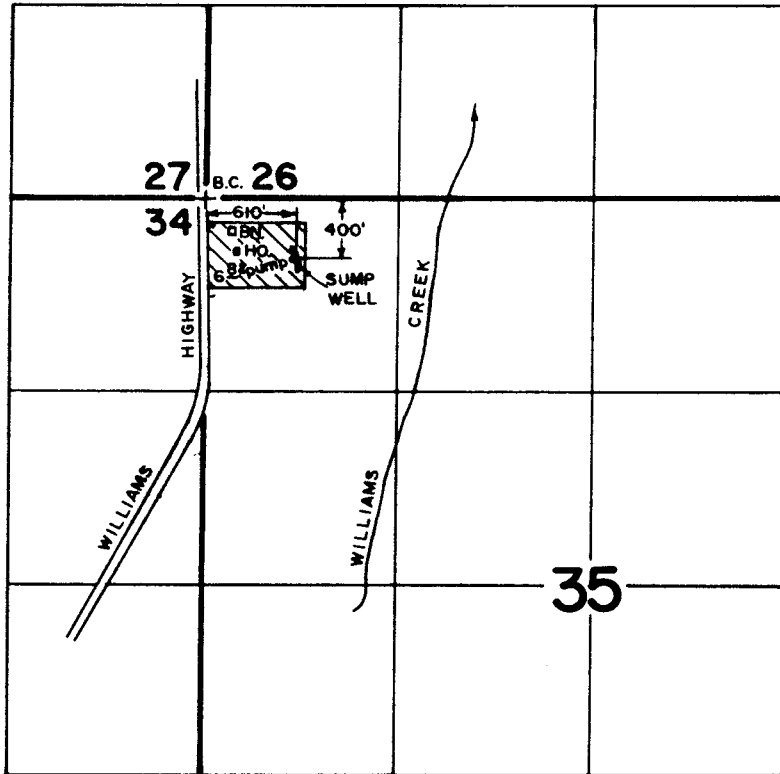

MAY 29 1989

**FINAL PROOF SURVEY**

UNDER

Application No. **G-8463** Permit No. **G-7923**  
IN NAME OF

**KENNETH T. ZETLMAIER**

Surveyed **AUG. 10**, 19**83**, by **B. SUZIE JAMES**

SCALE: 4" = 1 MILE

179-107R TWB