


T4S. R2E. WM.

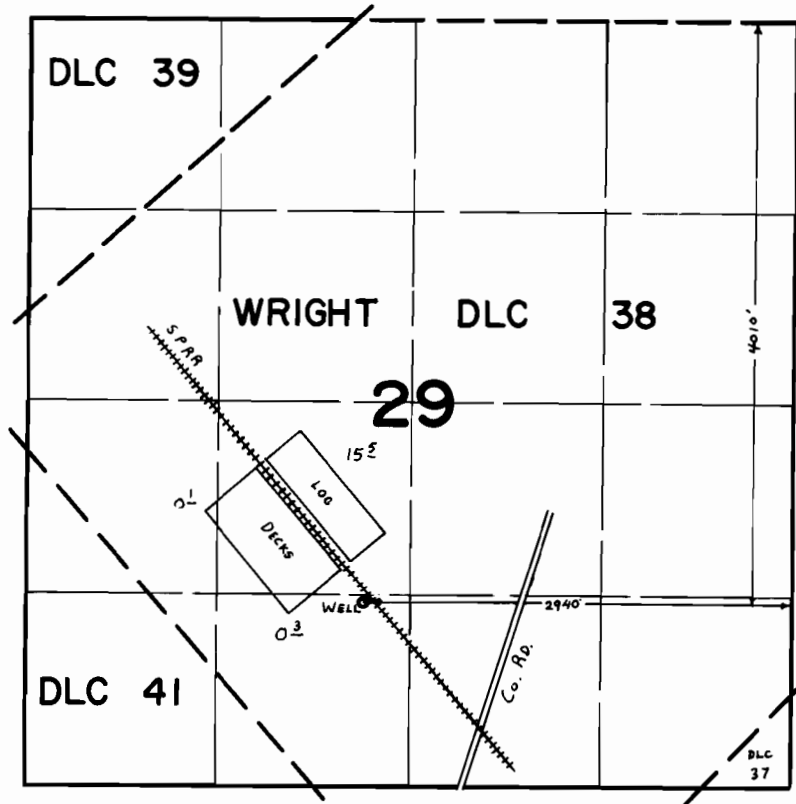

FINAL PROOF SURVEY UNDER

Application No. G-5647. Permit No. G-7928.
IN NAME OF

PUBLISHERS PAPER CO.

Surveyed OCT. 9 1978, by C. L. HUGHES.