


# MAP FOR ANNA ETZEL

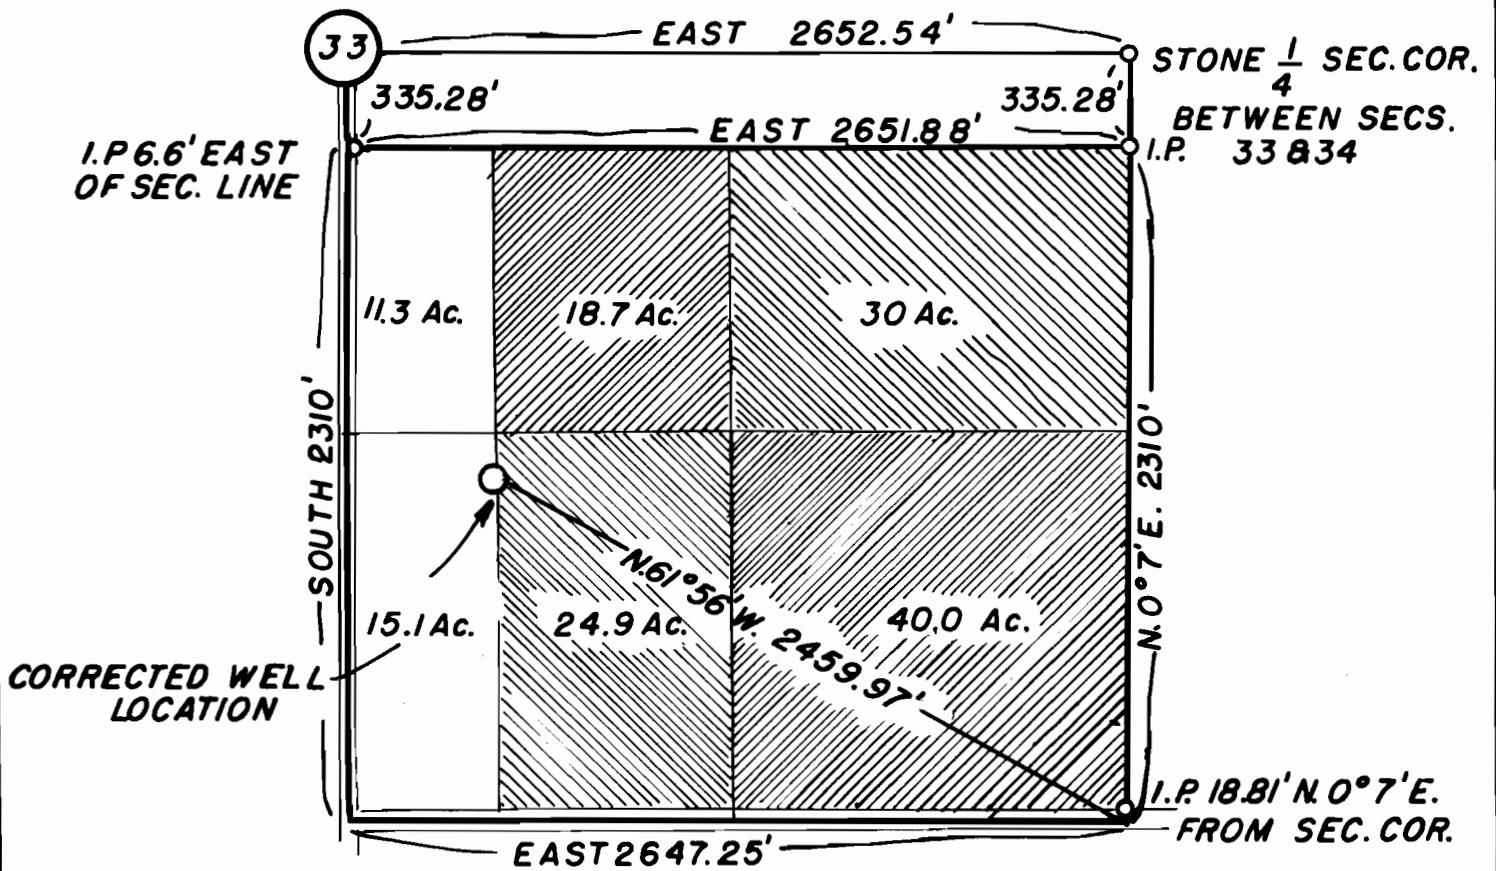

SEC. 33 T. 8 S. R. 2 W.

Application No. G-896  
Permit No. G-795

SCALE 1" = 10 CHAINS