


R 14 E

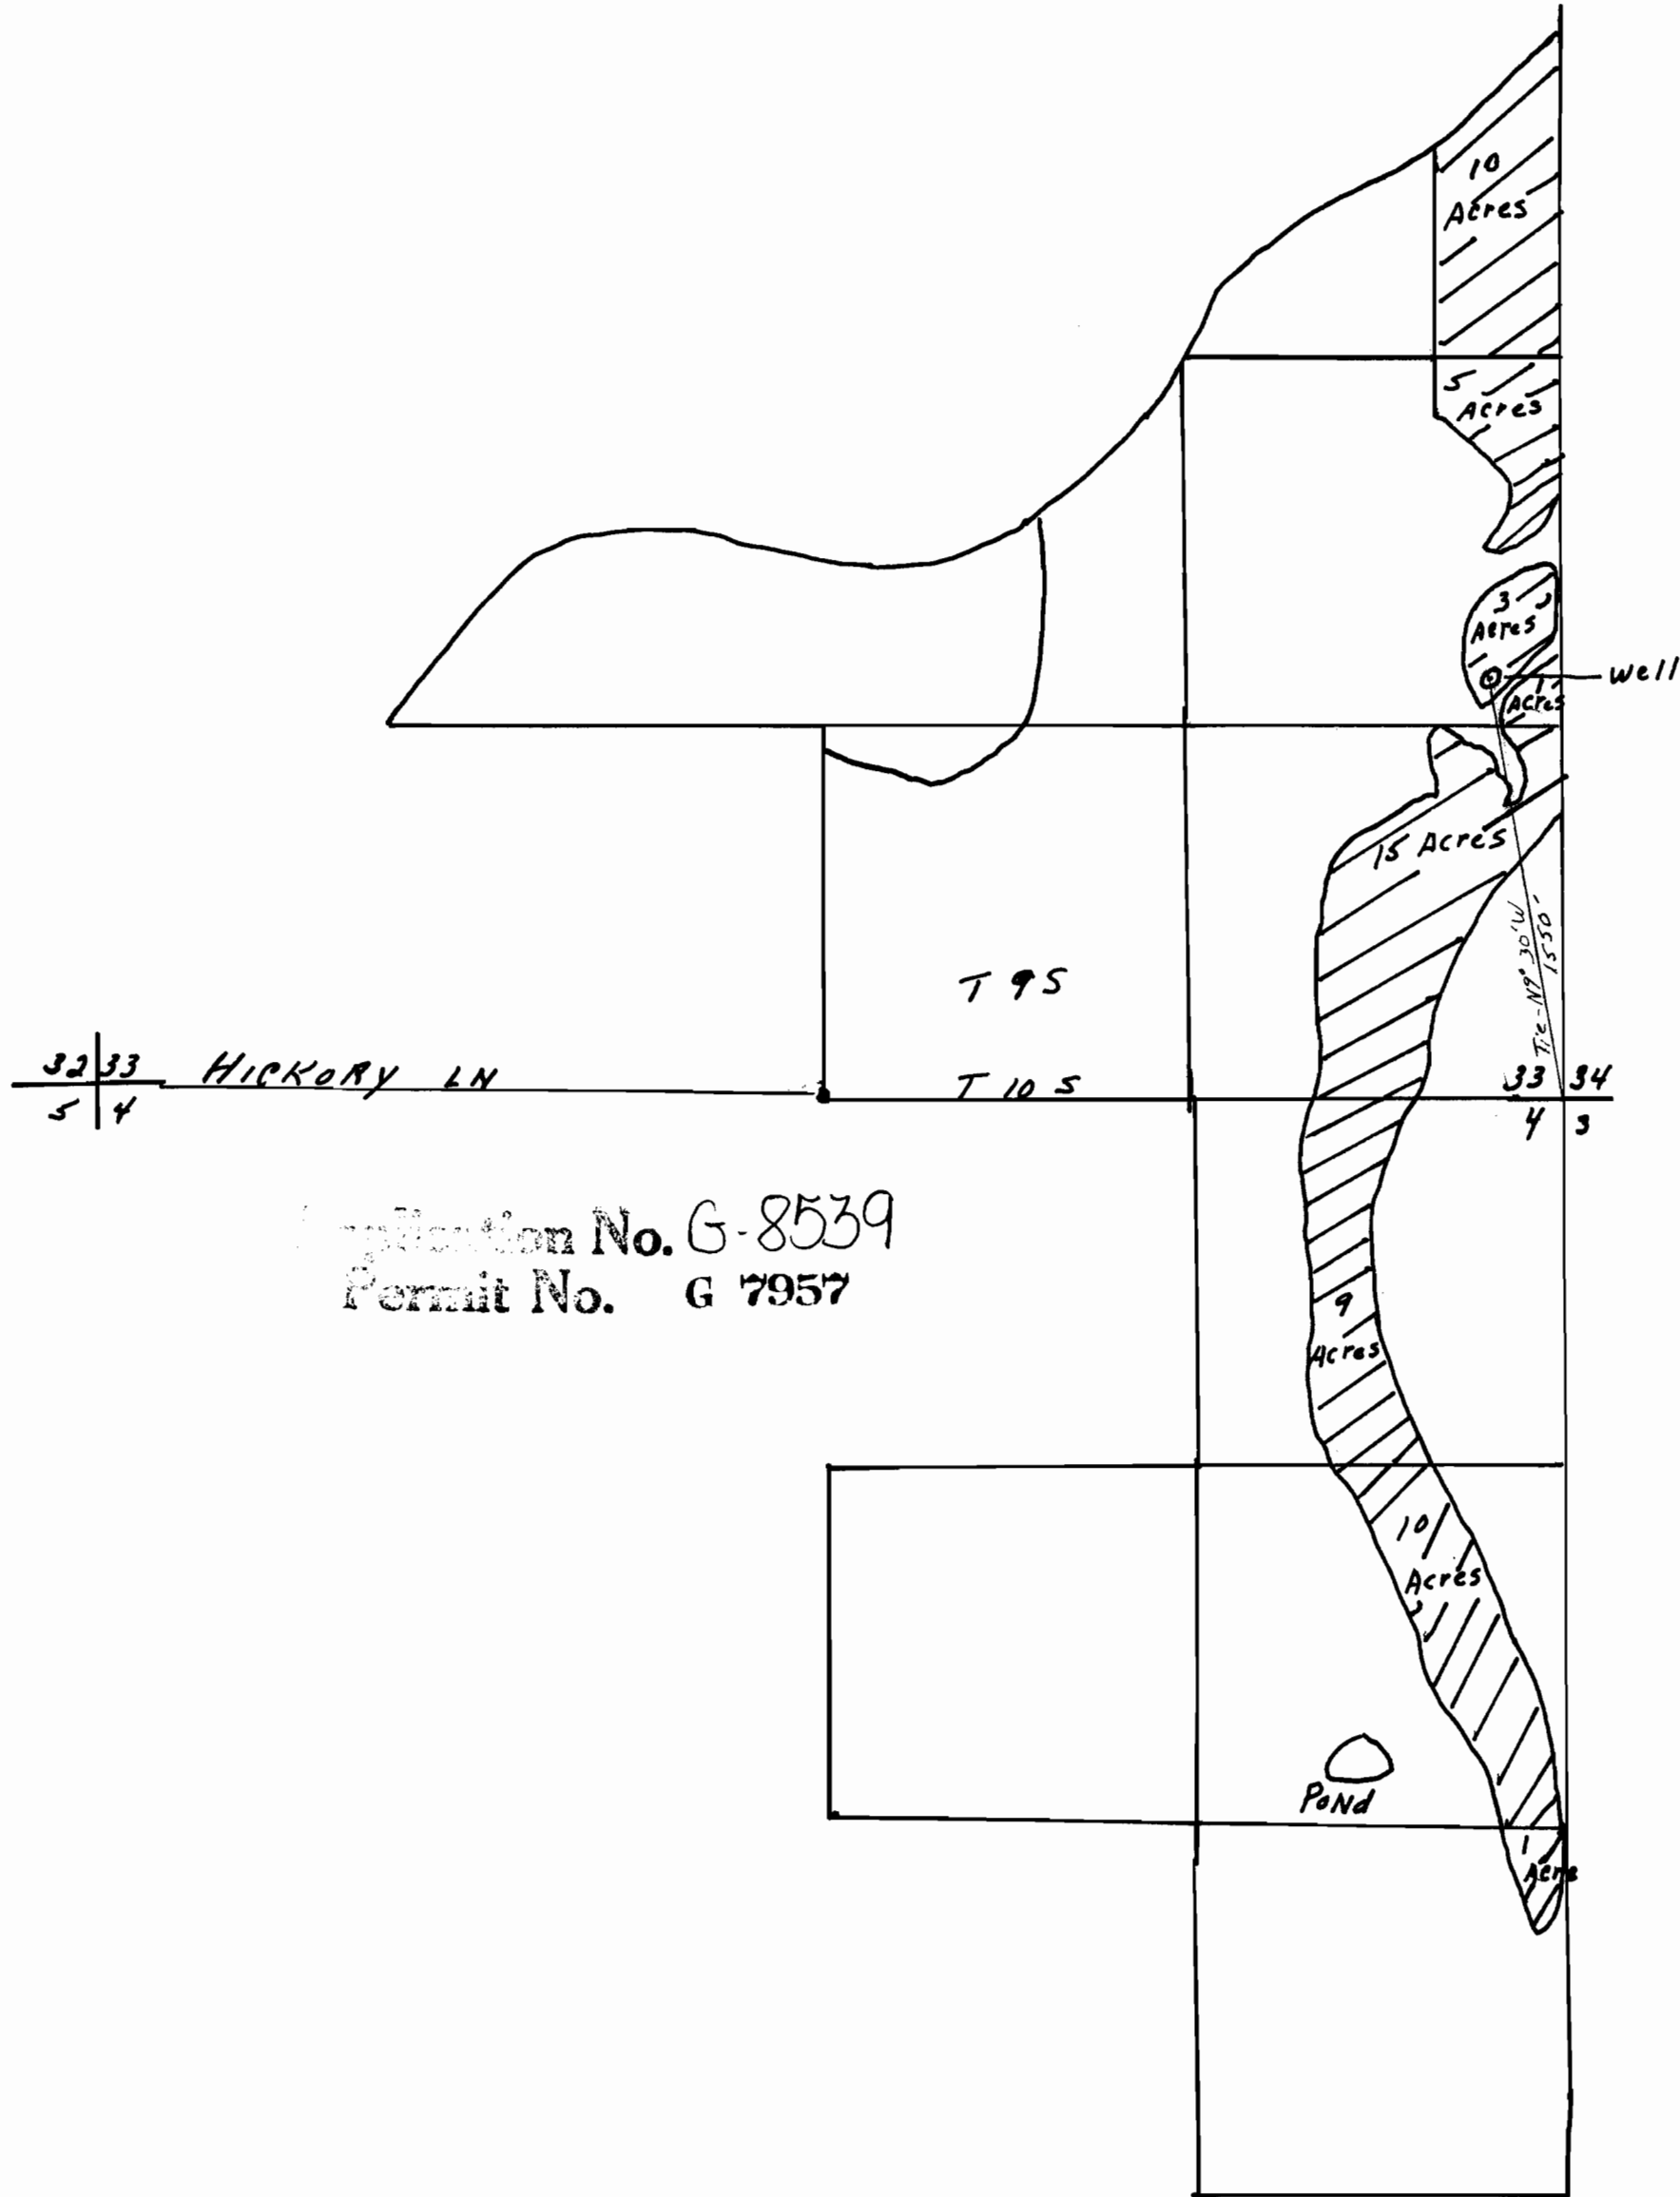

1204

4	3
9	10

LeRoy C. Fessler  
 Scale - 8" - mile  
 T-9S T10S R-14E