


G-7969
52921

T. 2N., R. 32E., W.M.

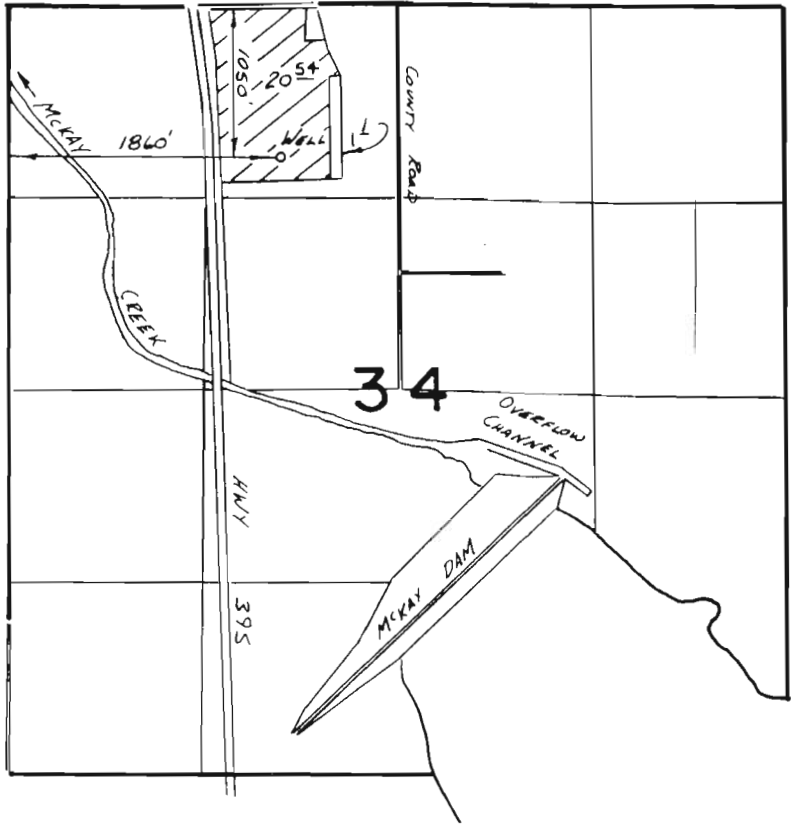

FINAL PROOF SURVEY
UNDER

Application No. G-8478 Permit No. G-7969
IN NAME OF

Fredrick J. LICKERSE

Surveyed May 19, 1982, by V. Church