


# SECTION PLAT

Section 32 Township 24 S Range 31 E  
County of HARNEY State of OREGON

NORTH

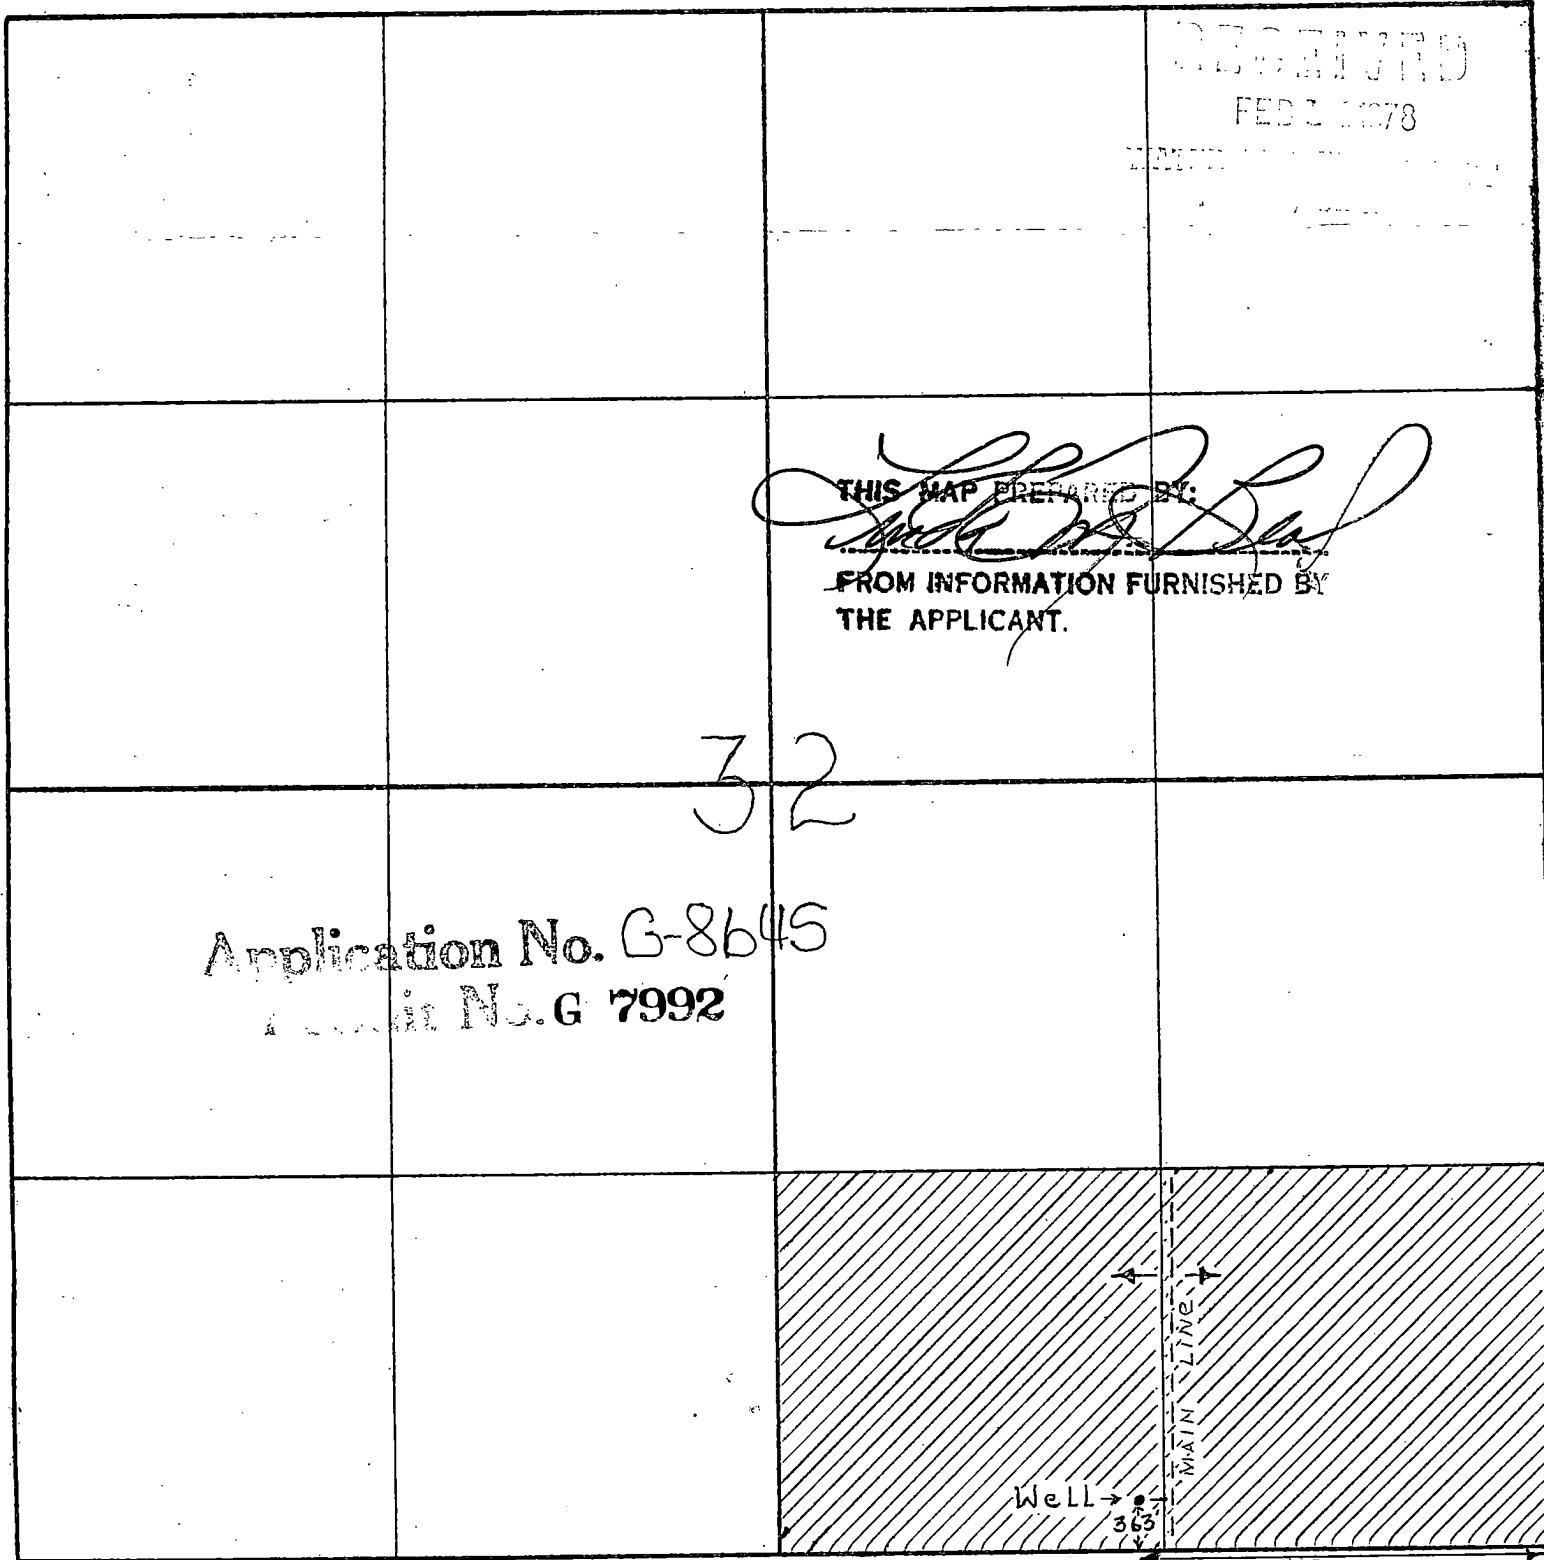

Remarks scale - 8" = 1 mile - 660'.

12" WELL 1465' WEST 363' NORTH  
SE 1/4