


T. 34 S., R. 6 W., W.M.

RECEIVED

JUL 3 1984

WM. DIST. 14
GRANTS PASS, ORE.

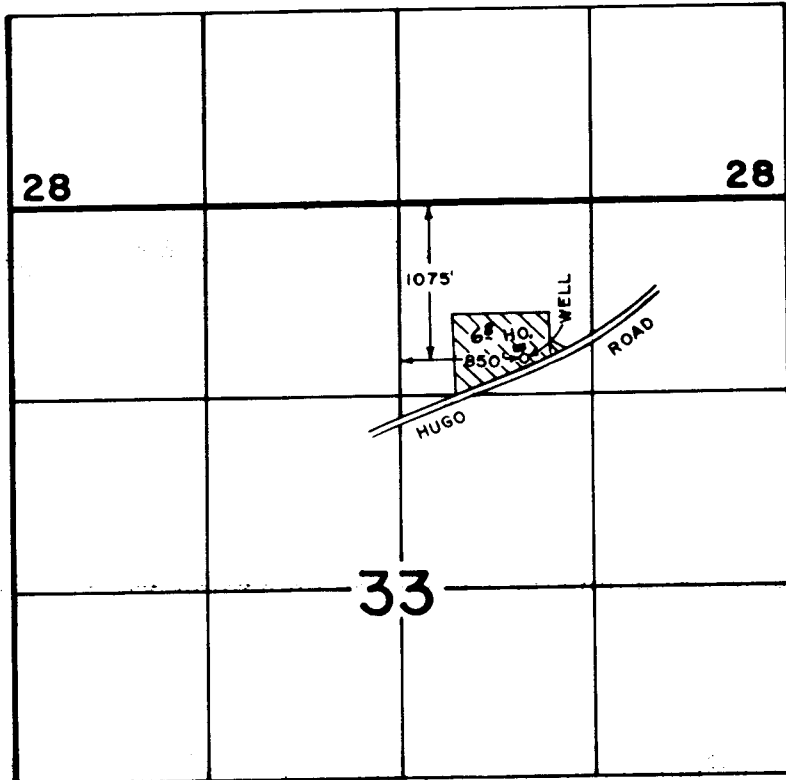

FINAL PROOF SURVEY
UNDER

Application No. G-8631 Permit No. G-8001 *C-52148*
IN NAME OF

JEROME G. HATFIELD

Surveyed SEPT. 15, 19.82, by B. SUZIE JAMES

SCALE: 4" = 1 MILE

179-151R TWB