

NW 1/4 SE 1/4 SECTION 25 T1S R3W W.M.

WASHINGTON COUNTY OREGON


SCALE 1" = 100'

IS 3 2508
West Laurel Acres Water Co. Inc
Rt 2 Box 331
Cornelius, Oregon 97113
(503)628-1750

RECEIVED

JUN 2 1978

WATER RESOURCES DEPT.
SALEM, OREGON

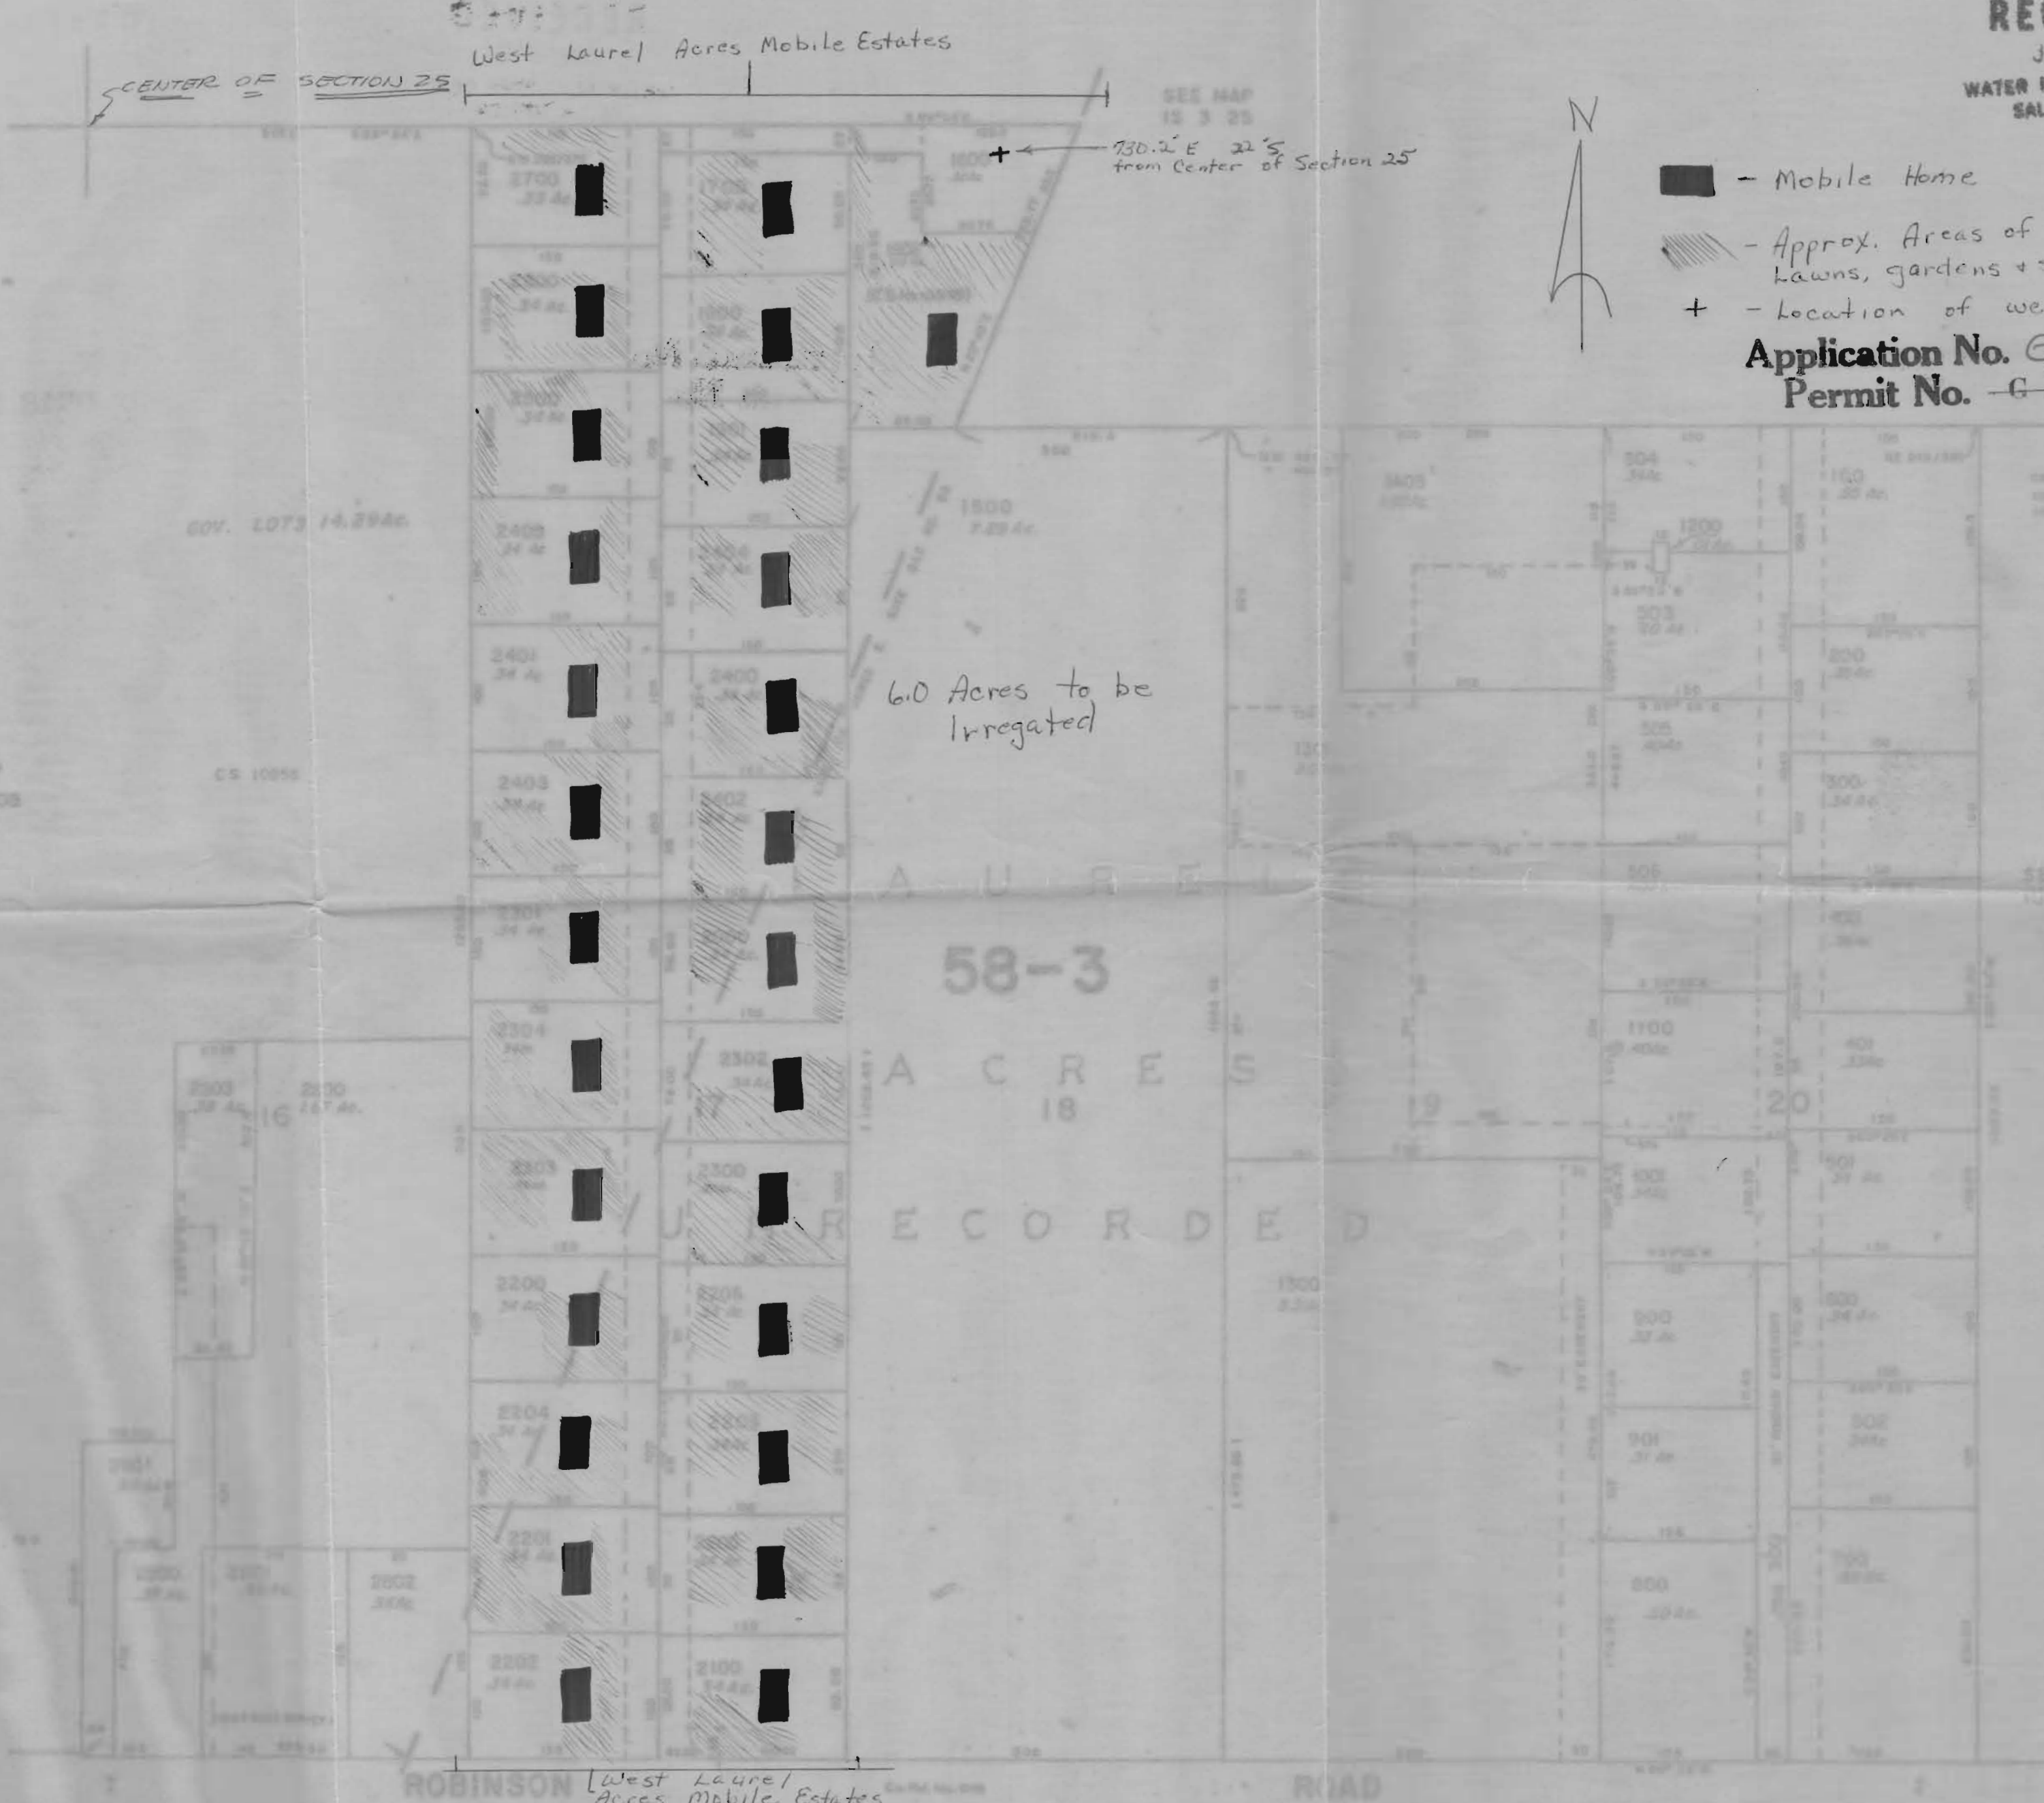

- - Mobile Home
- ▨ - Approx. Areas of lawns, gardens + shrubs
- + - Location of well

Application No. G-8833
Permit No. ~~G 8120~~ G8130

6.0 Acres to be Irrigated

58-3

ACRES

RECORDED

ROBINSON West Laurel Acres Mobile Estates ROAD

MAY 31 1978

IS 3 2508