


T.4S.R.2 W.W.M.

RECEIVED
MAY 1 1958
STATE ENGINEER
SALEM, OREGON

Scale 1" = 132.0'

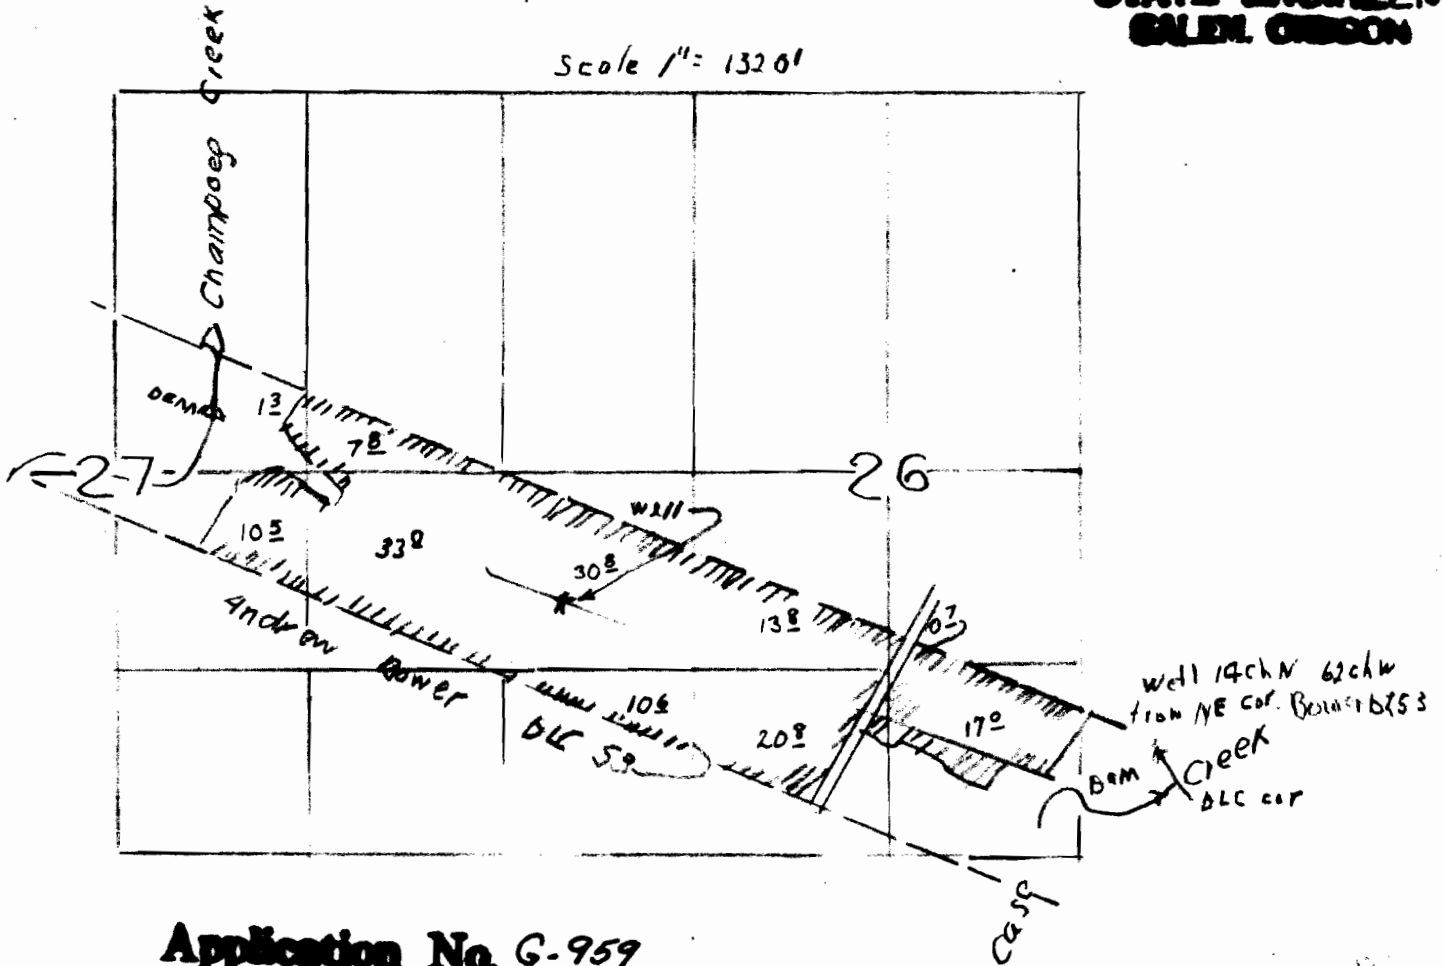

Application No. G-959
Permit No. G-815.