


RECEIVED

JAN 29 1986

WATER RESOURCES DEPT
SALEM, OREGON

Application No. G-11419
Permit No.

T. 4S., R. 1W., W.M.

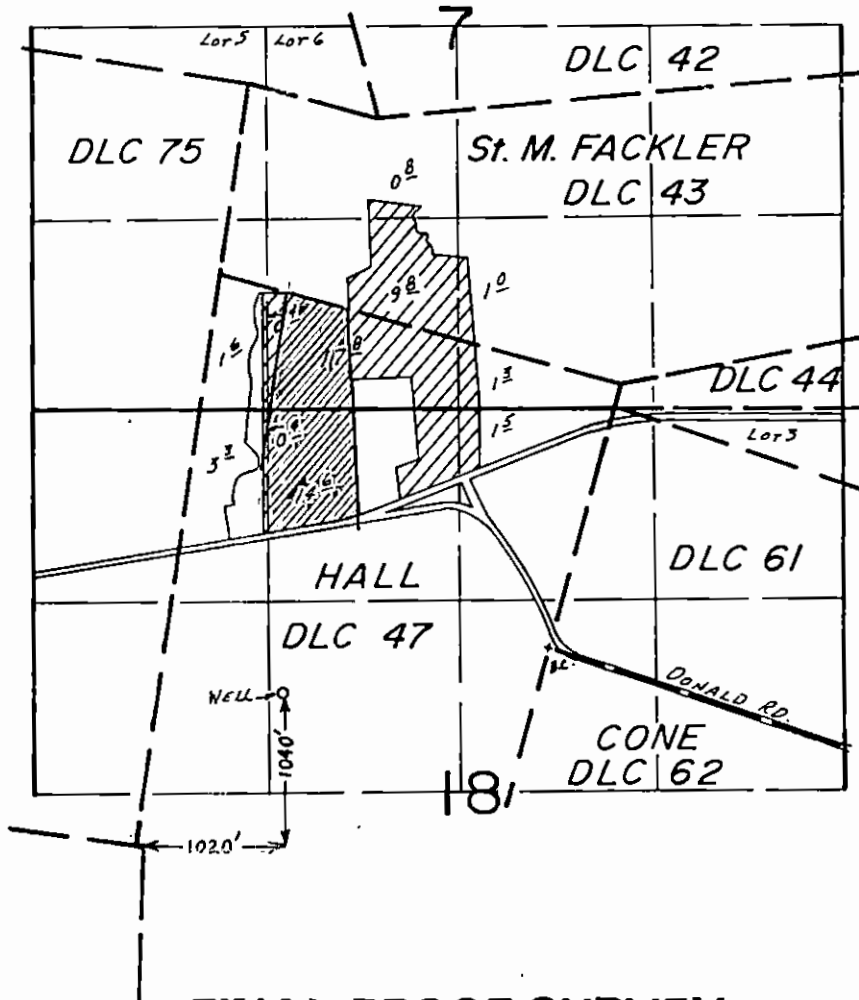

FINAL PROOF SURVEY
UNDER

Application No. G-7860 Permit No. G-8165.....
IN NAME OF

.....FRANCIS X. RYAN.....

Surveyed OCT. 4.... 1983., by L.M. TOLL.....