


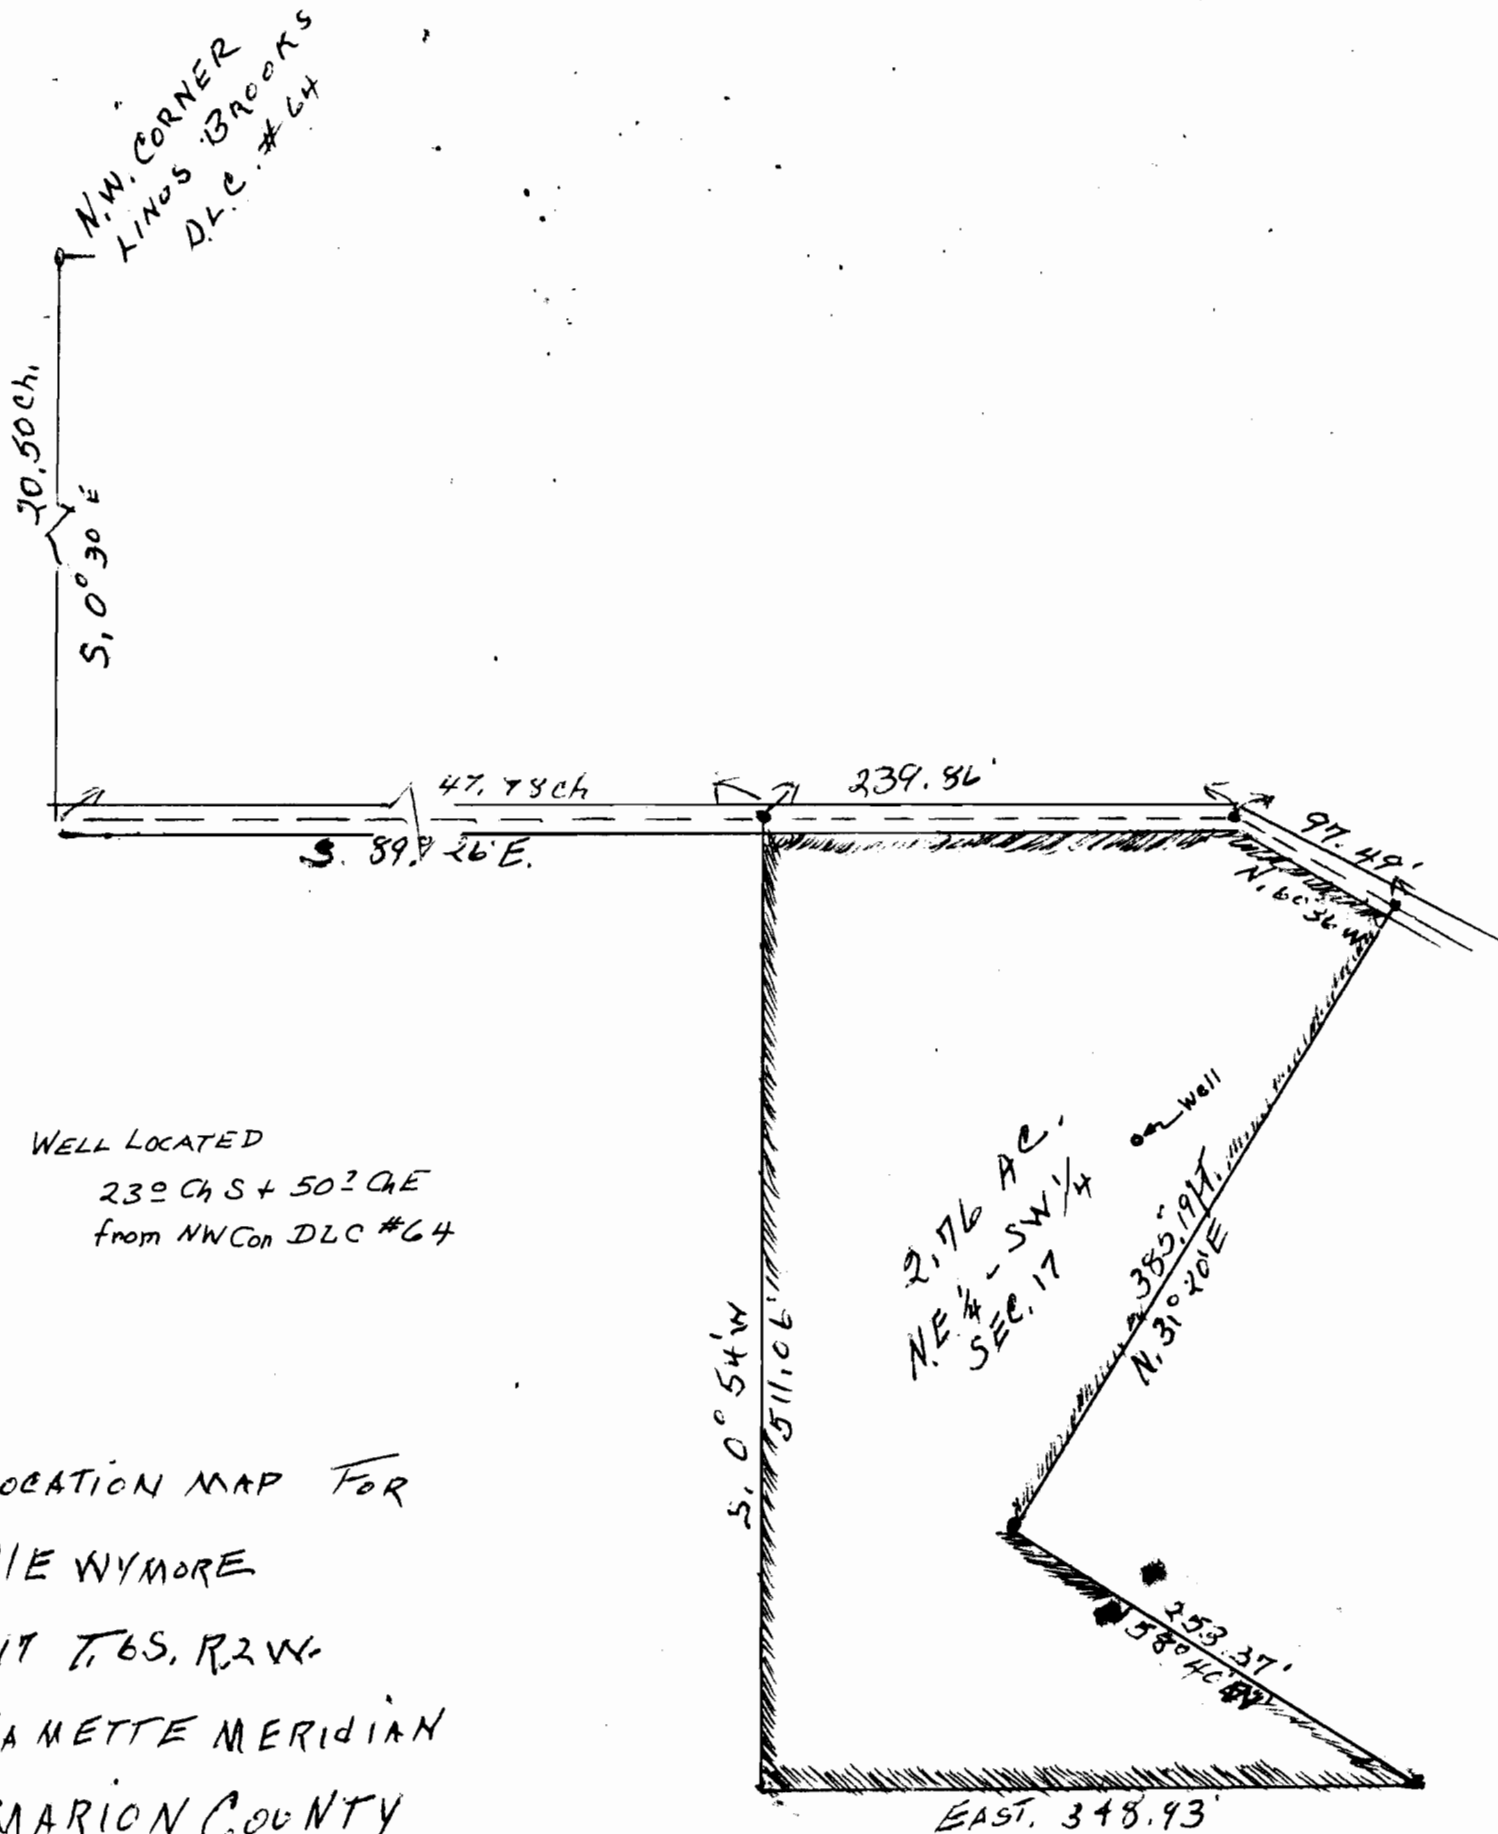

WELL LOCATION MAP FOR

ORVILLE WYMORE

SEC. 17 T. 6 S. R. 2 W.

WILLAMETTE MERIDIAN

MARION COUNTY

OREGON

SCALE 1" = 100'

Application No. G-964

Permit No. G-817