


T.9&10S.,R.14E.,W.M.

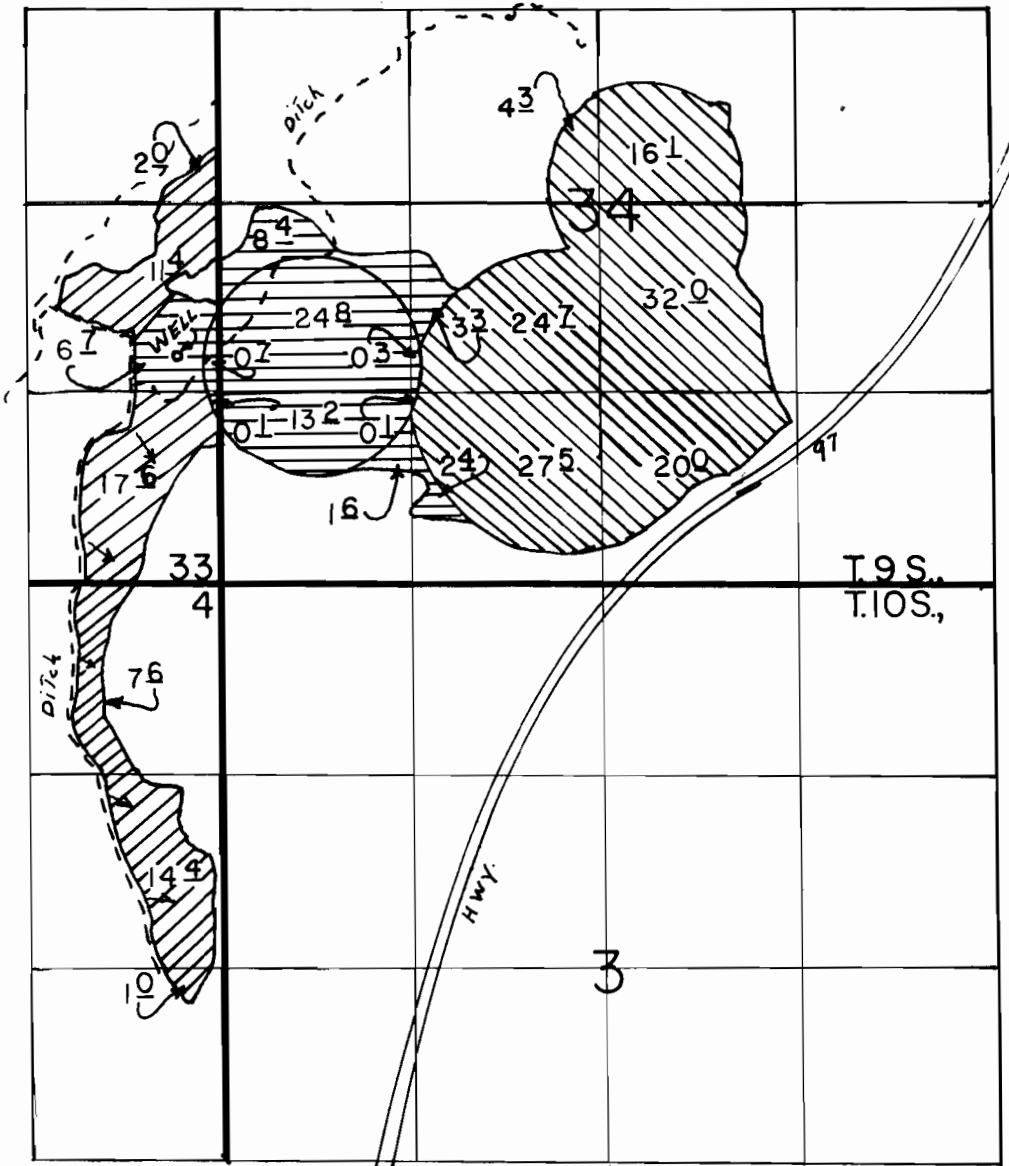

WELL LOC: 1550' N & 280' W FROM SE COR. OF SEC 33.

SCALE: 1" = 1320'

FINAL PROOF SURVEY
UNDER

Application No. G-8539 Permit No. G-7957
 G-9199 G-8568
 G-8768 G-8179

Priority, Nov. 18, 1977
 Priority April 16, 1979
 Priority April 26, 1978

IN NAME OF

54
124
61

..... LEROY C. FESSLER

Surveyed AUG. 9, 1995, by R.M. SUTTERFIELD