


RECEIVED

JUL 18 1978

WATER RESOURCES DEPT.
SALEM, OREGON

T. 40 S., R. 8 E., W. M.

36

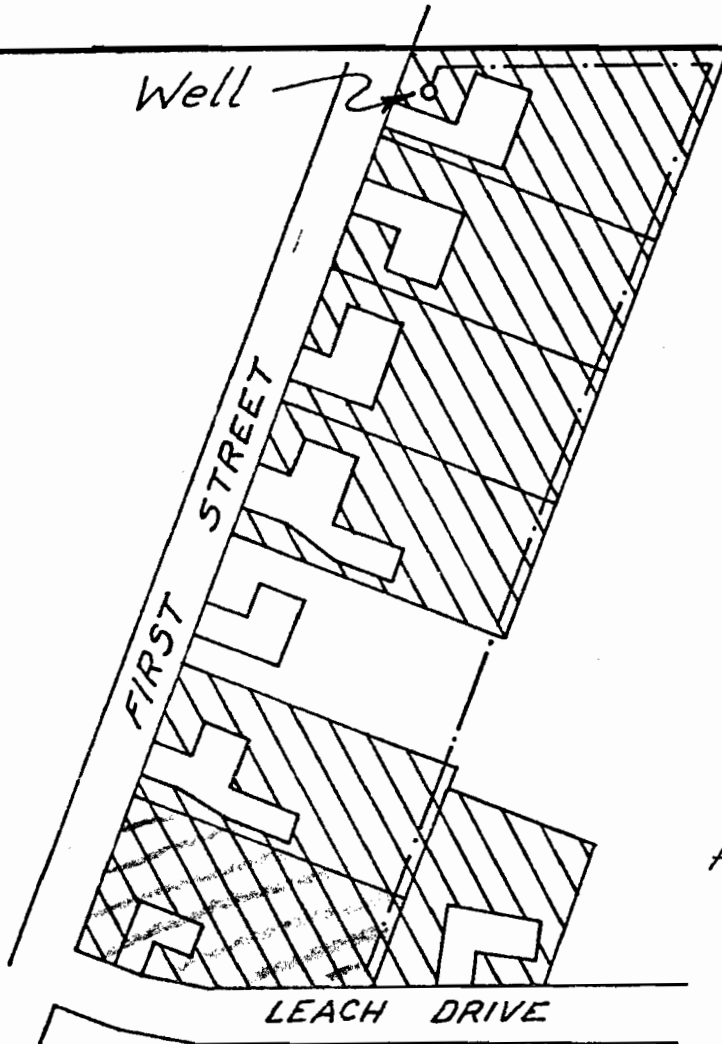

6⁵ Acres

Well Loc.: 42 ft. S., & 550 ft. E;
from N¹/₄ Cor., Section 1

Scale 1" = 200'

Application Map For
Glenn D. & Rose Quigley

Application No.: G-7657
Permit No.: G 8204