


T.39S., R.5W., W.M.

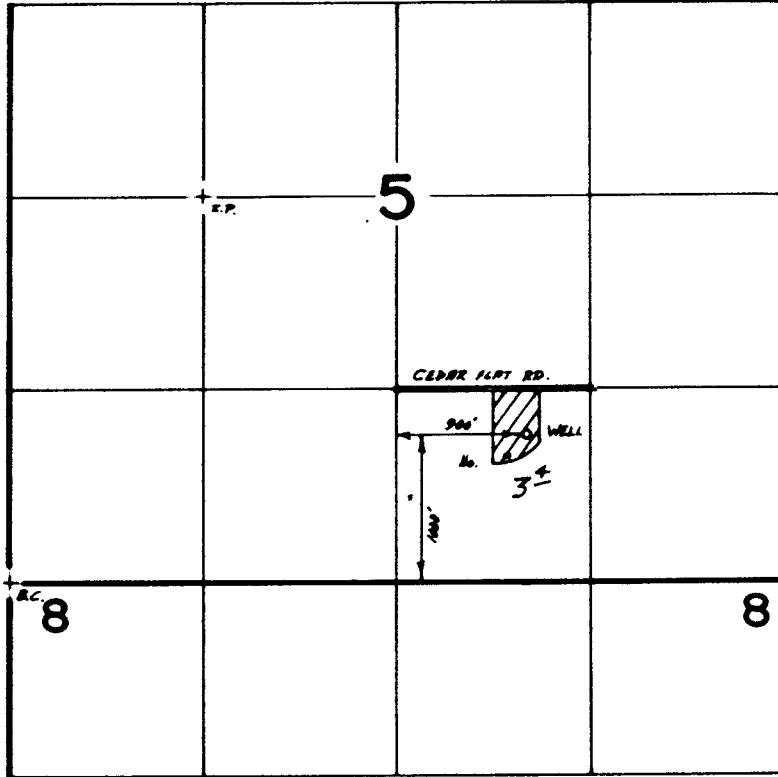

Scale 1"=1320'

FINAL PROOF SURVEY UNDER

FEB 27 1989

Application No. ~~G-8808~~ Permit No. ~~G-8206~~
IN NAME OF

.....MICHAEL J. & HENRIETTA R. BUCK

Surveyed Aug...13.. 1984, by B.S. JAMES.....

41033-179-87R

B.S.J.