T.8 S. R.3W.
1" = 200'

RECEIVED
AUG 7 1978
WATER RESOURCES DEPT.
SALEM, OREGON

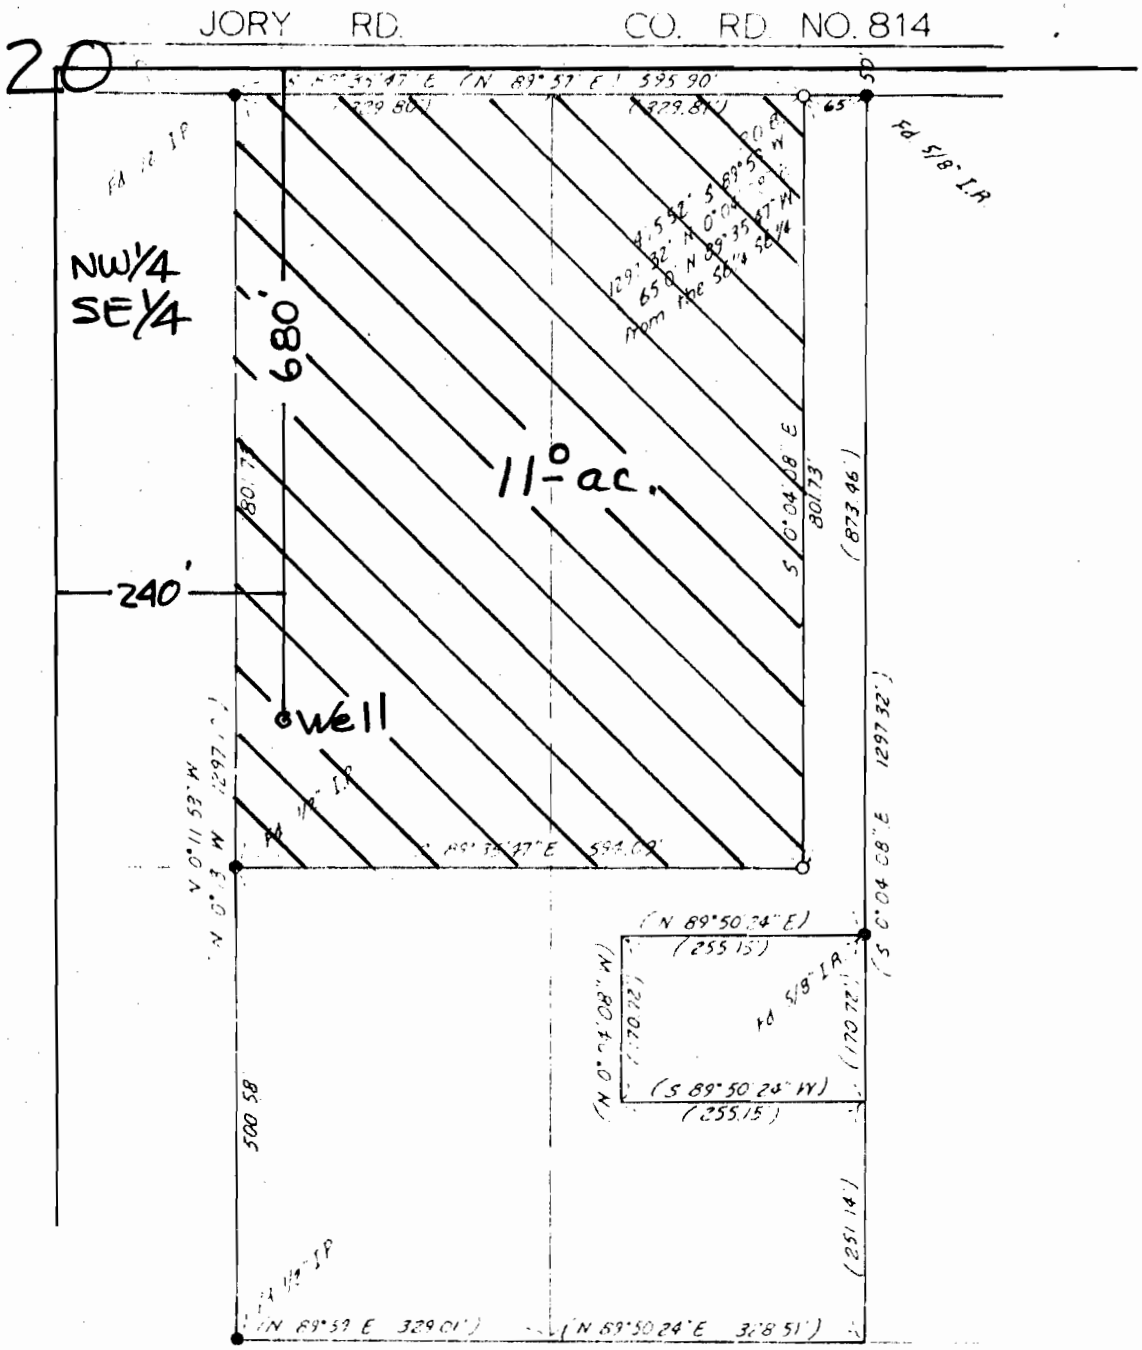

Application No. G-8919
Permit No. G 8288