
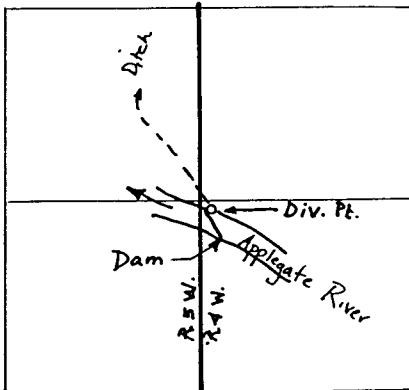


T. 37 S., R. 5 W., W.M.

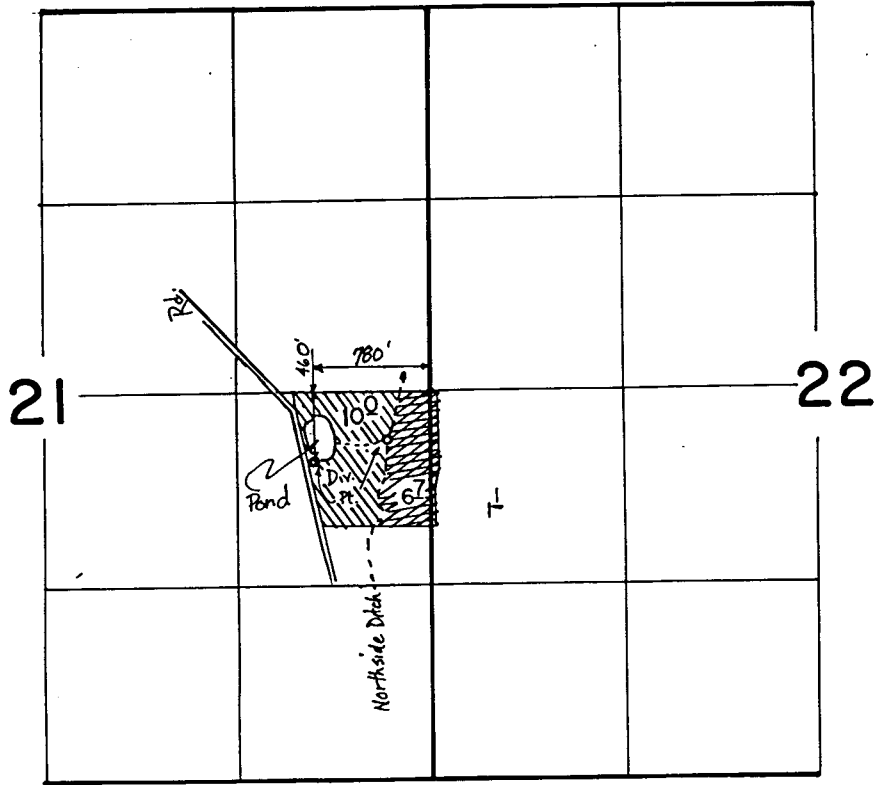

Div. Pt. located 4000' S. & 80' E. from N.W. Cor. Sec. 6, T. 38 S., R. 4 W.

Scale: 4" = 1 mile

FINAL PROOF SURVEY
UNDER

63416	46770	
62349	46624	

Application No. G-8896 Permit No. G-8313
IN NAME OF

EDGAR C. & PHYLLIS M. OWEN

Surveyed Mar...29, 1982, by Bruce R. Sund.
Aug. 18, 1983, B. S. JAMES