


2012 10/16/1978, 11, 12 - in vicinity of Sec. 6, Range 1W, Township 5S, Range 1W
The exception of 32 rods off the south end of Lot 20.
2.3 Acres

2

Application No. G-8970
Permit No. G 8340

RECEIVED
OCT 16 1978
WATER RESOURCES DEPT.
SALEM, OREGON

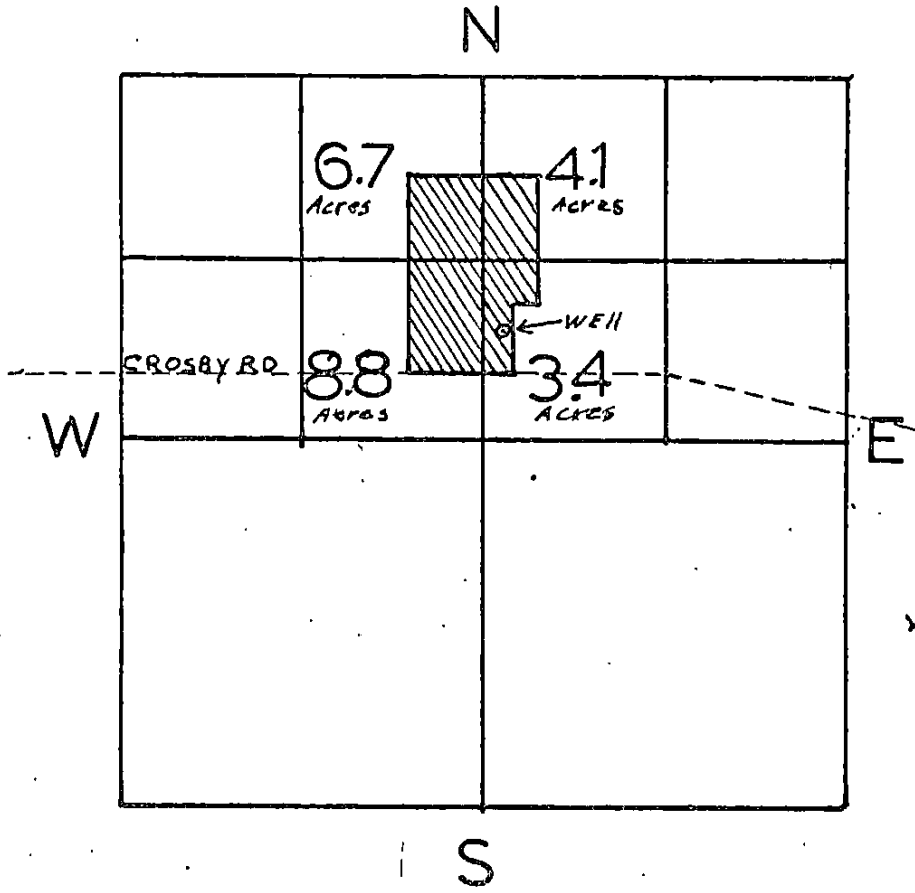

Well located
810ft N. & 130ft E.
from the center corner
of Sec. 6

Scale 4" = 1 mile

Section 6, Township 5S, Range 1W

JACK & ALICE HUNT