


T.9&10S., R.3W., W.M.

Application No. G 9013

Permit No. G 8388

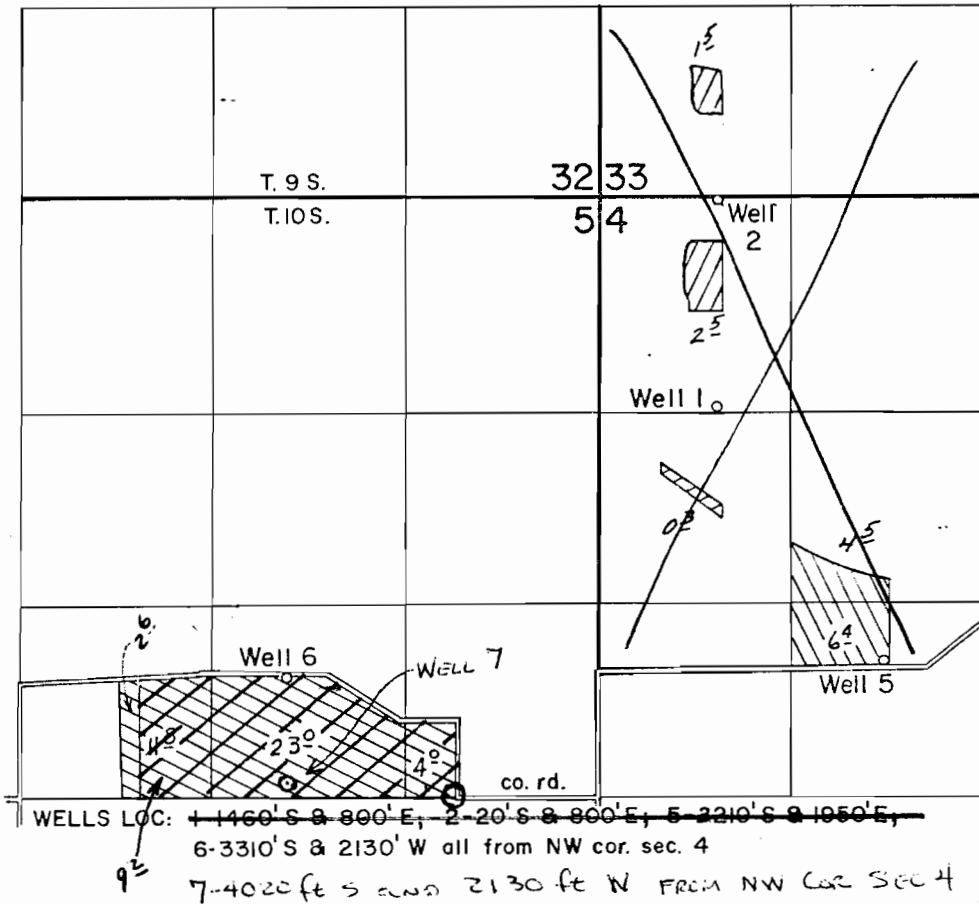

RECEIVED

NOV 14 1978






WATER RESOURCES DEPT.
SALEM, OREGON

FINAL PROOF SURVEY UNDER

Application No. G-5942 Permit No. G-5747
IN NAME OF

DEE S. & ROBERTA E. CHAMBERS

 Surveyed April 15 1976, by D. Norby

-  Well 1
-  Well 2
-  Well 5
-  Well 6 pri
& well 7 suppl.
-  Well 7
suppl.