


T. 39 & 40 S., R. 8 W., W. M.

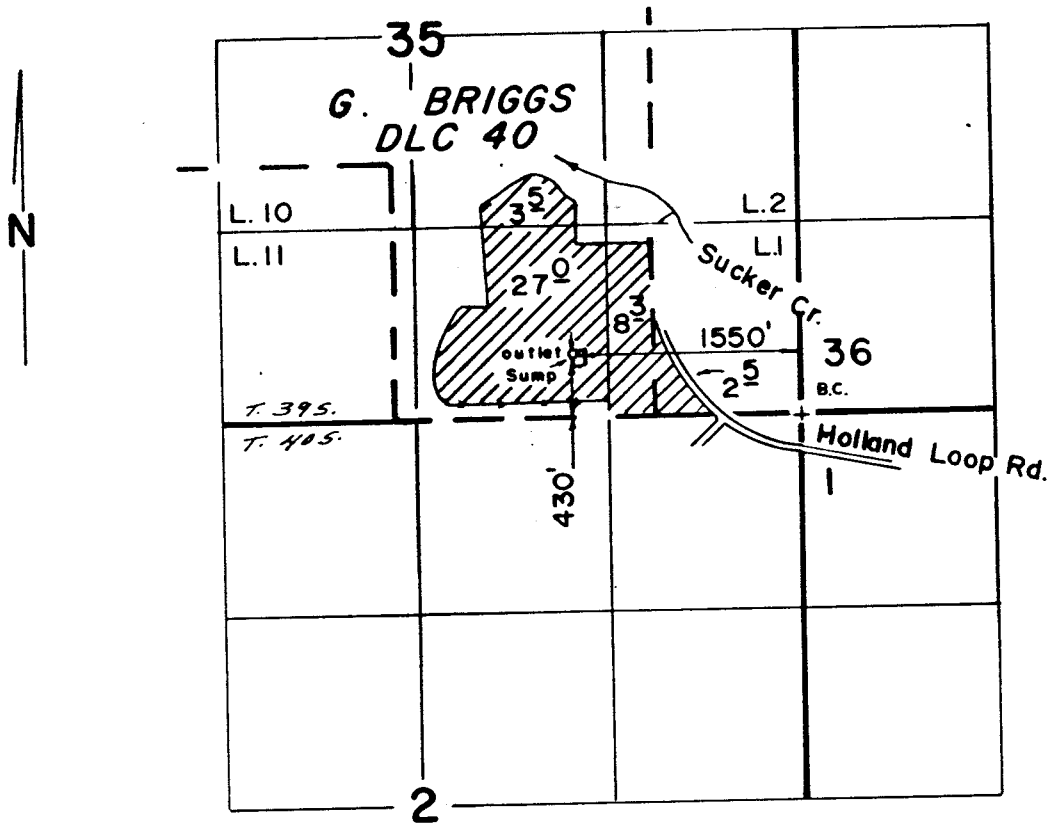

Scale: 1" = 1320'

MAY 15 1986

**FINAL PROOF SURVEY**  
UNDER

Application No. ~~G-8998~~ Permit No. ~~G-8434~~  
IN NAME OF

GEORGIA L. TREFETHEN

Surveyed MAY. 15. 19.86, by B...S...JAMES.