


Application No. 67-9064  
Permit No. G 8436

T. 37S. 2W. W. M.

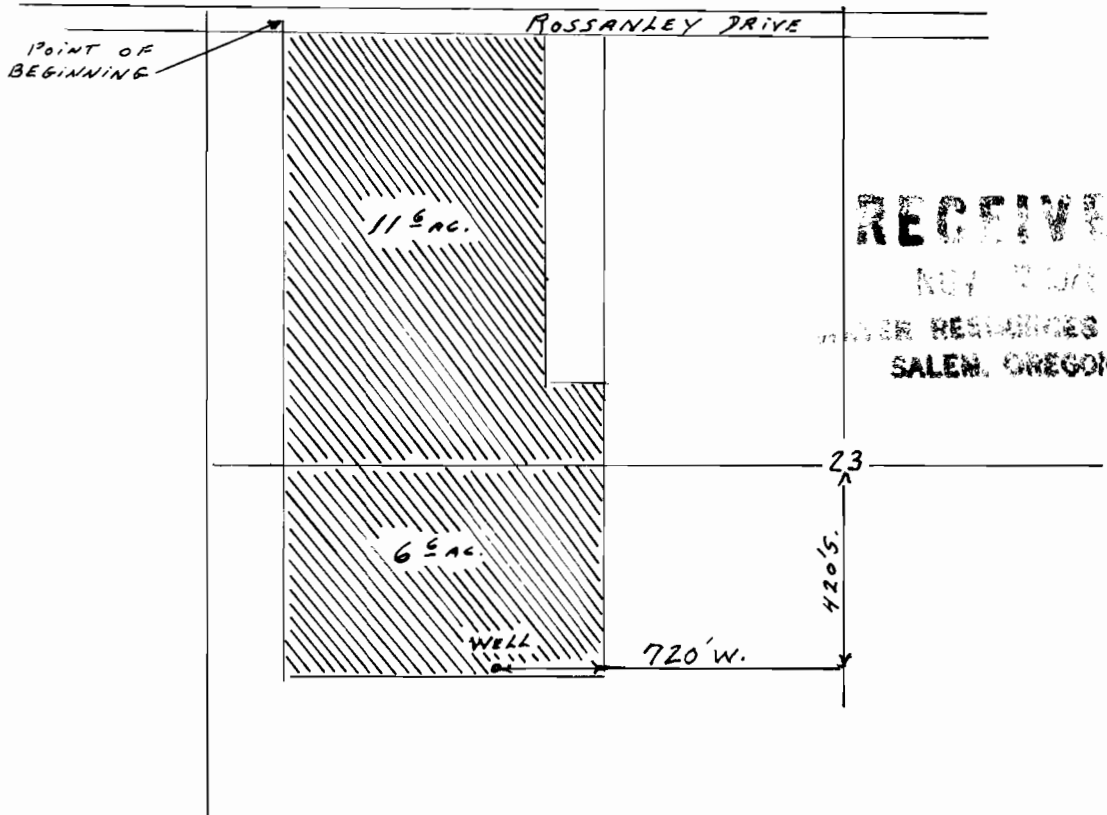

RECEIVED  
NOV 2 1978  
WATER RESOURCES DEPT.  
SALEM, OREGON

MAP TO ACCOMPANY APPLICATION OF  
JOE E. AND/OR FRANCES M. BROOKS FOR  
IRRIGATION FROM A WELL

SCALE 1" = 400'



10-31-78