


**RECEIVED**

FEB 27 1979

T. 30S. R. 5W. W.M.

**WATER RESOURCES DEPT.  
SALEM, OREGON**

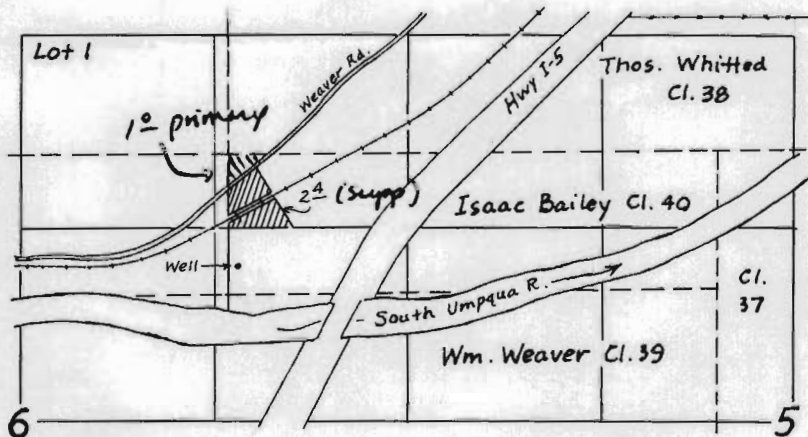

Scale: 4" = 1 mile

Well located 770'S and 60'E from SE cor. Lot 1

Application No. G-9152

Permit No. G 8477