


RECEIVED

APR 20 1979

WATER RESOURCES DEPT.
SALEM, OREGON

S 1/2 of The SE 1/4 Sec 19
Twp. 40 S R. 12 E. W. M.
1" = 440'

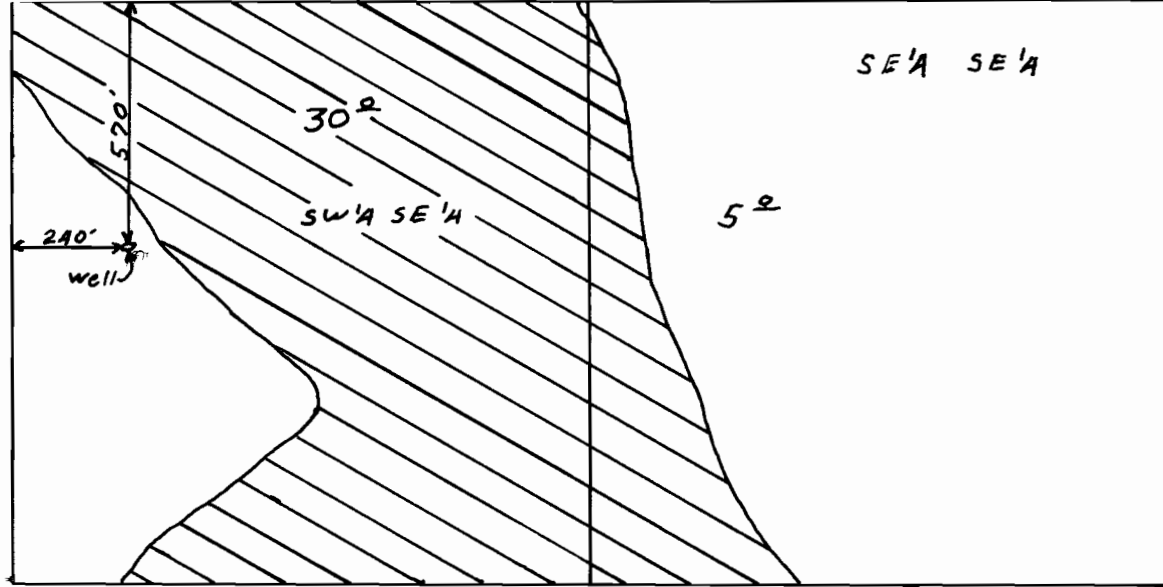

Application No. G 9207
Permit No. G 8529