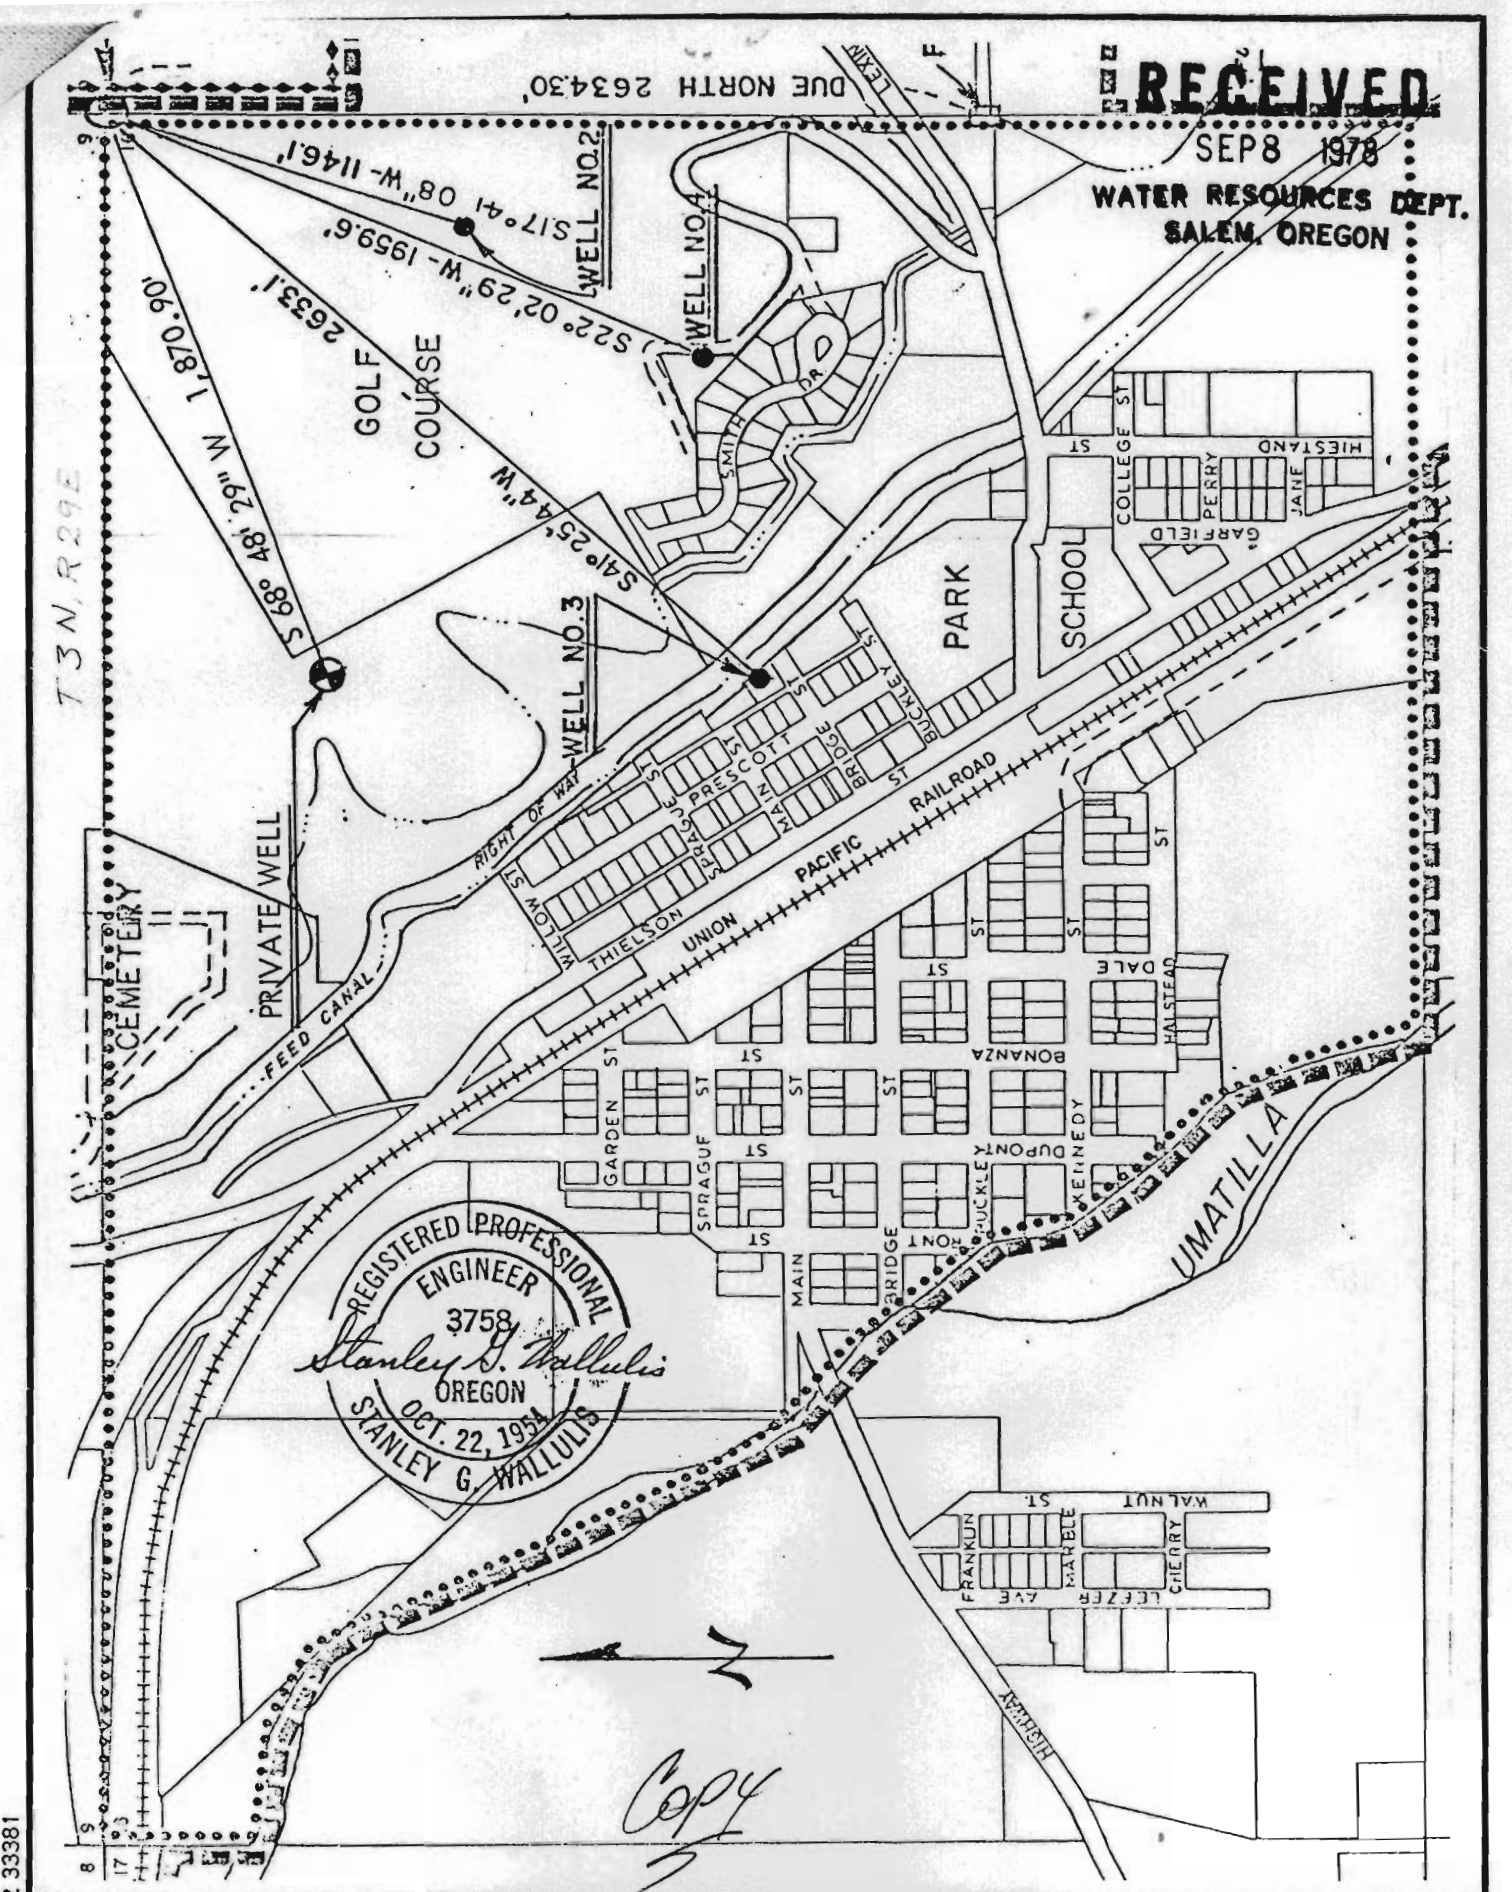

PROJ. LOCATION SURVEY OF PRIVATE WELL	WALLULIS & ASSOCIATES, INC. ENGINEERING & PLANNING 5 S.E. NYE 108 E. MAIN PENDLETON 276-1598 HERMISTON OREGON 567-3331	SCALE 1" = 600'	NO. 76-113
TITLE City of Echo, Oregon Deep Well Protest		DATE Sept. 7, 1978	

BRUNING 40-22 33381