

Application No. G-9224

Permit No. G 3558


RECEIVED

MAY 03 1979

T.7 S. R. 2 W. W.M.

WATER RESOURCES DEPT.
SALEM, OREGON

NOTE:
Streets are
show only in
vicinity of wells

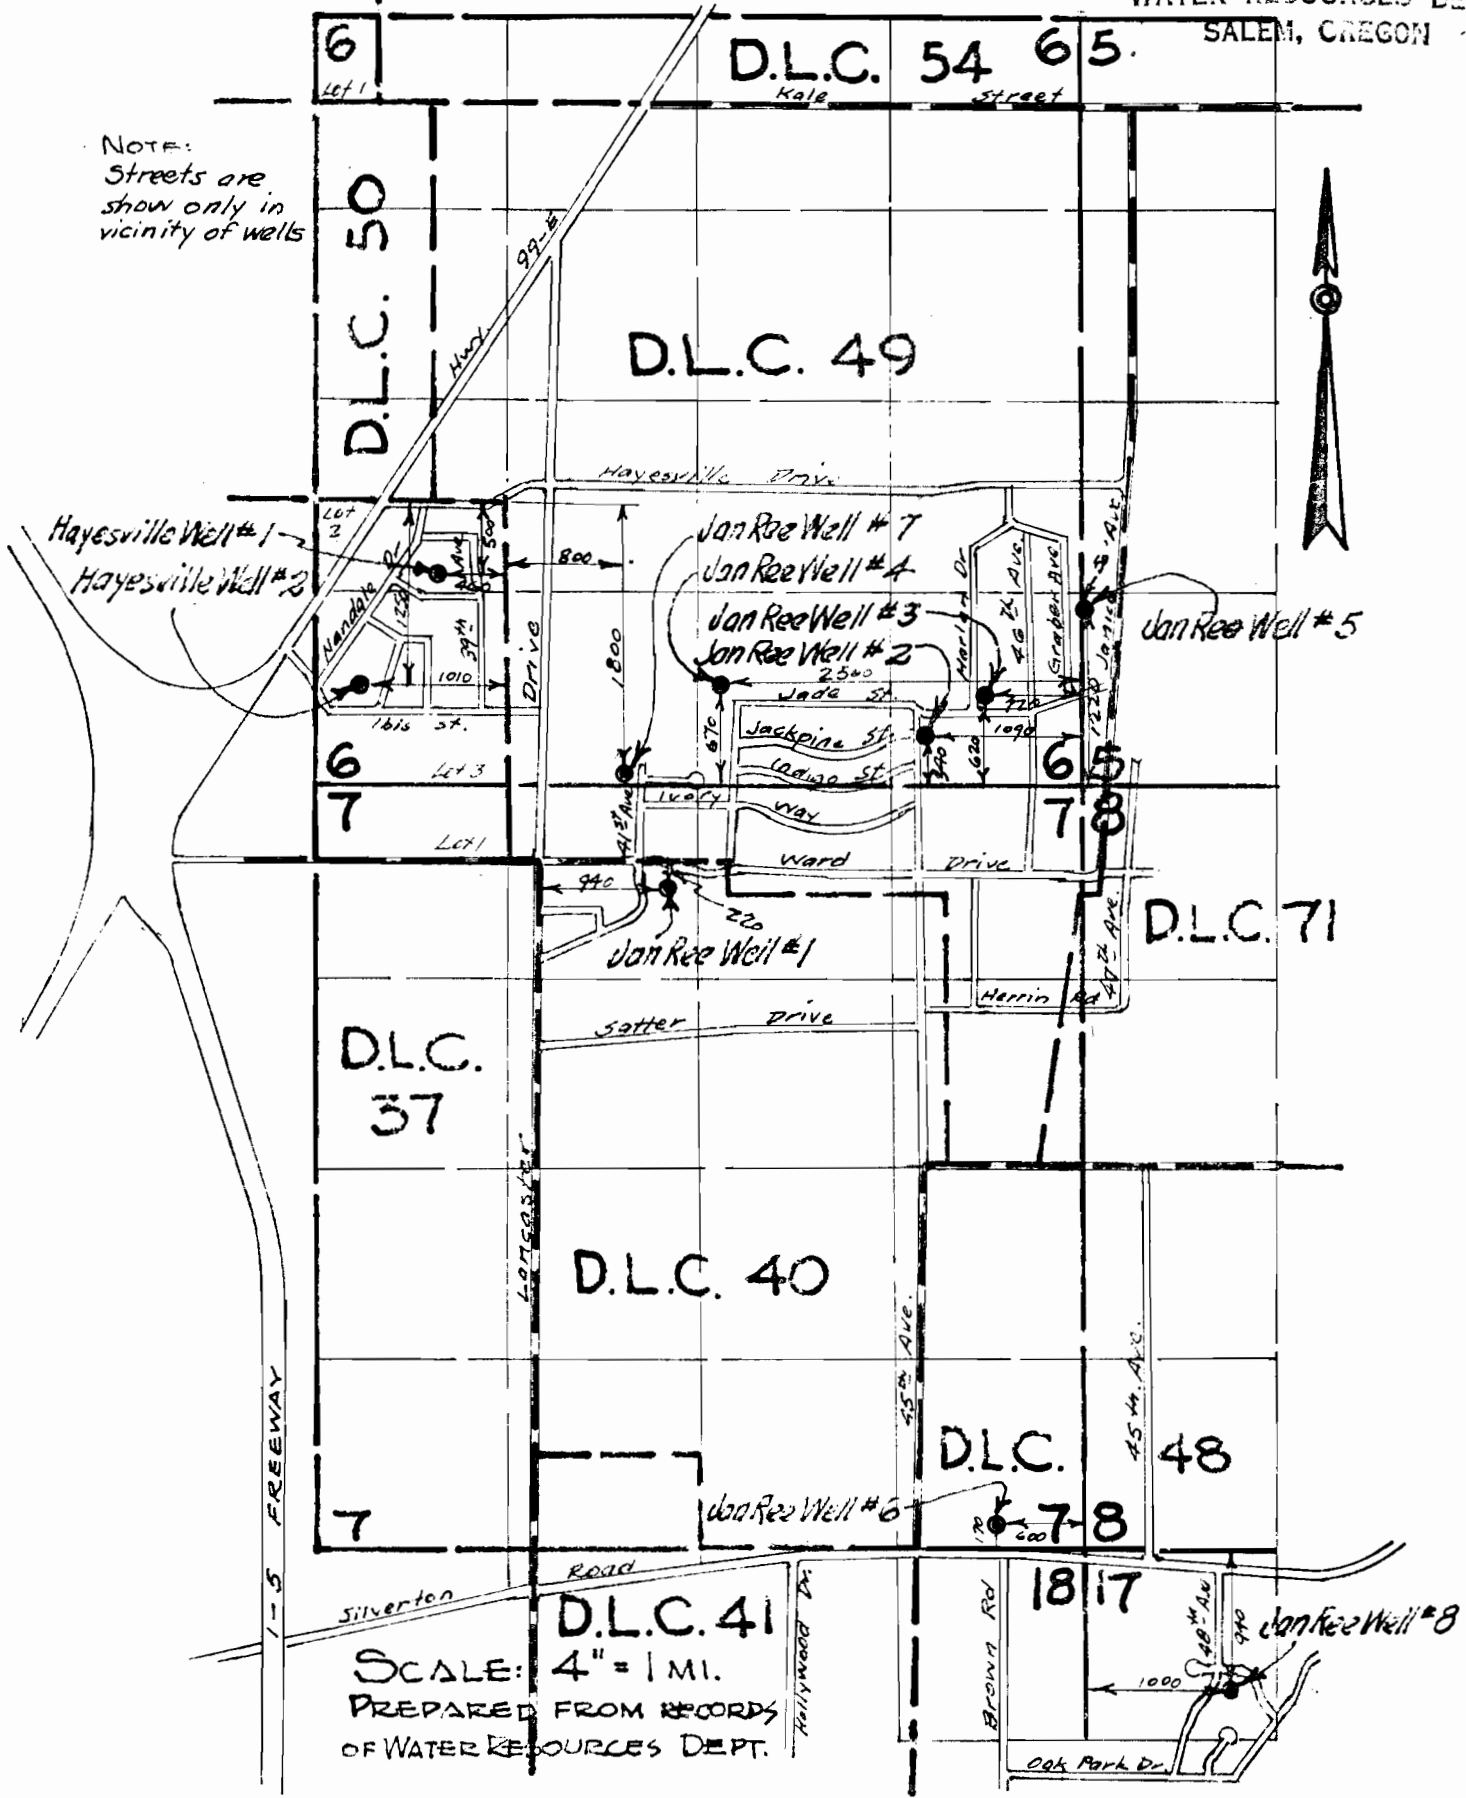

SCALE: 4" = 1 MI.
PREPARED FROM RECORDS
OF WATER RESOURCES DEPT.