


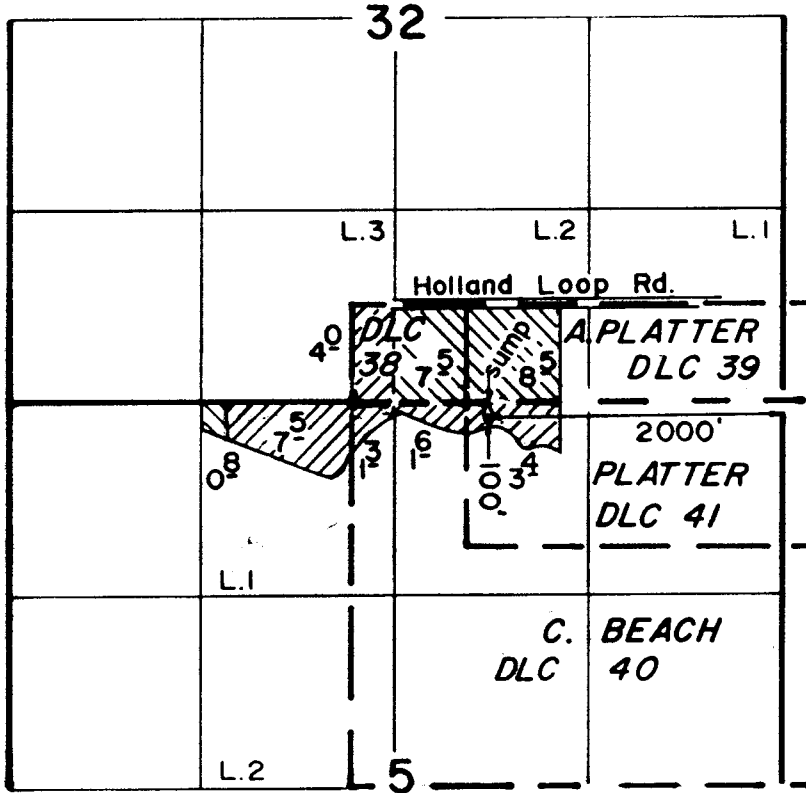

T. 39 & 40 S., R. 7 W., W.M.



MAY 27 1989

Scale: 1" = 1320

-  Primary
-  Supplemental

FINAL PROOF SURVEY
UNDER

Application No. G-9165 Permit No. G-8577
IN NAME OF

DEAN MAYFIELD

Surveyed MAY 12 1986, by B. S. JAMES