

G-1426
C-8593

Sec. 20 T.6N. R.35E.W.M.

UMATILLA COUNTY


RECEIVED

MAY 07 1979

WATER RESOURCES DEPT.
SALEM, OREGON

1" = 400'

See Map 6N 35 17

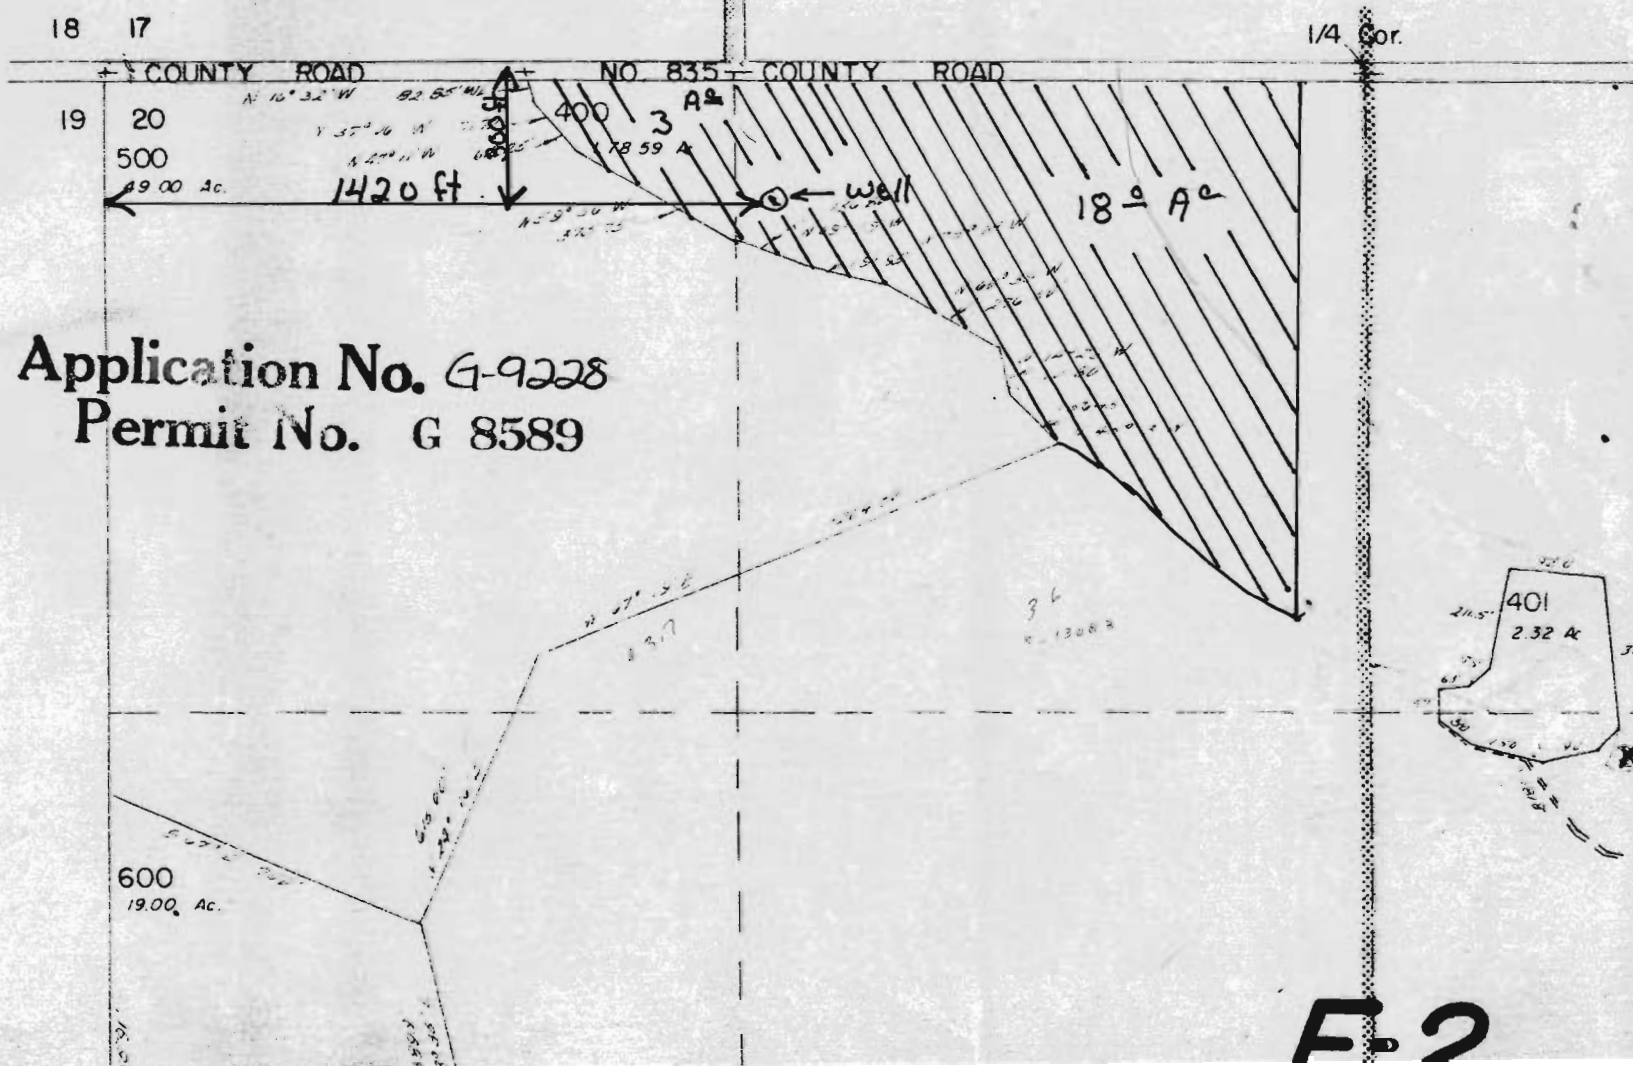

Application No. G-9228
Permit No. G 8589

F-2