


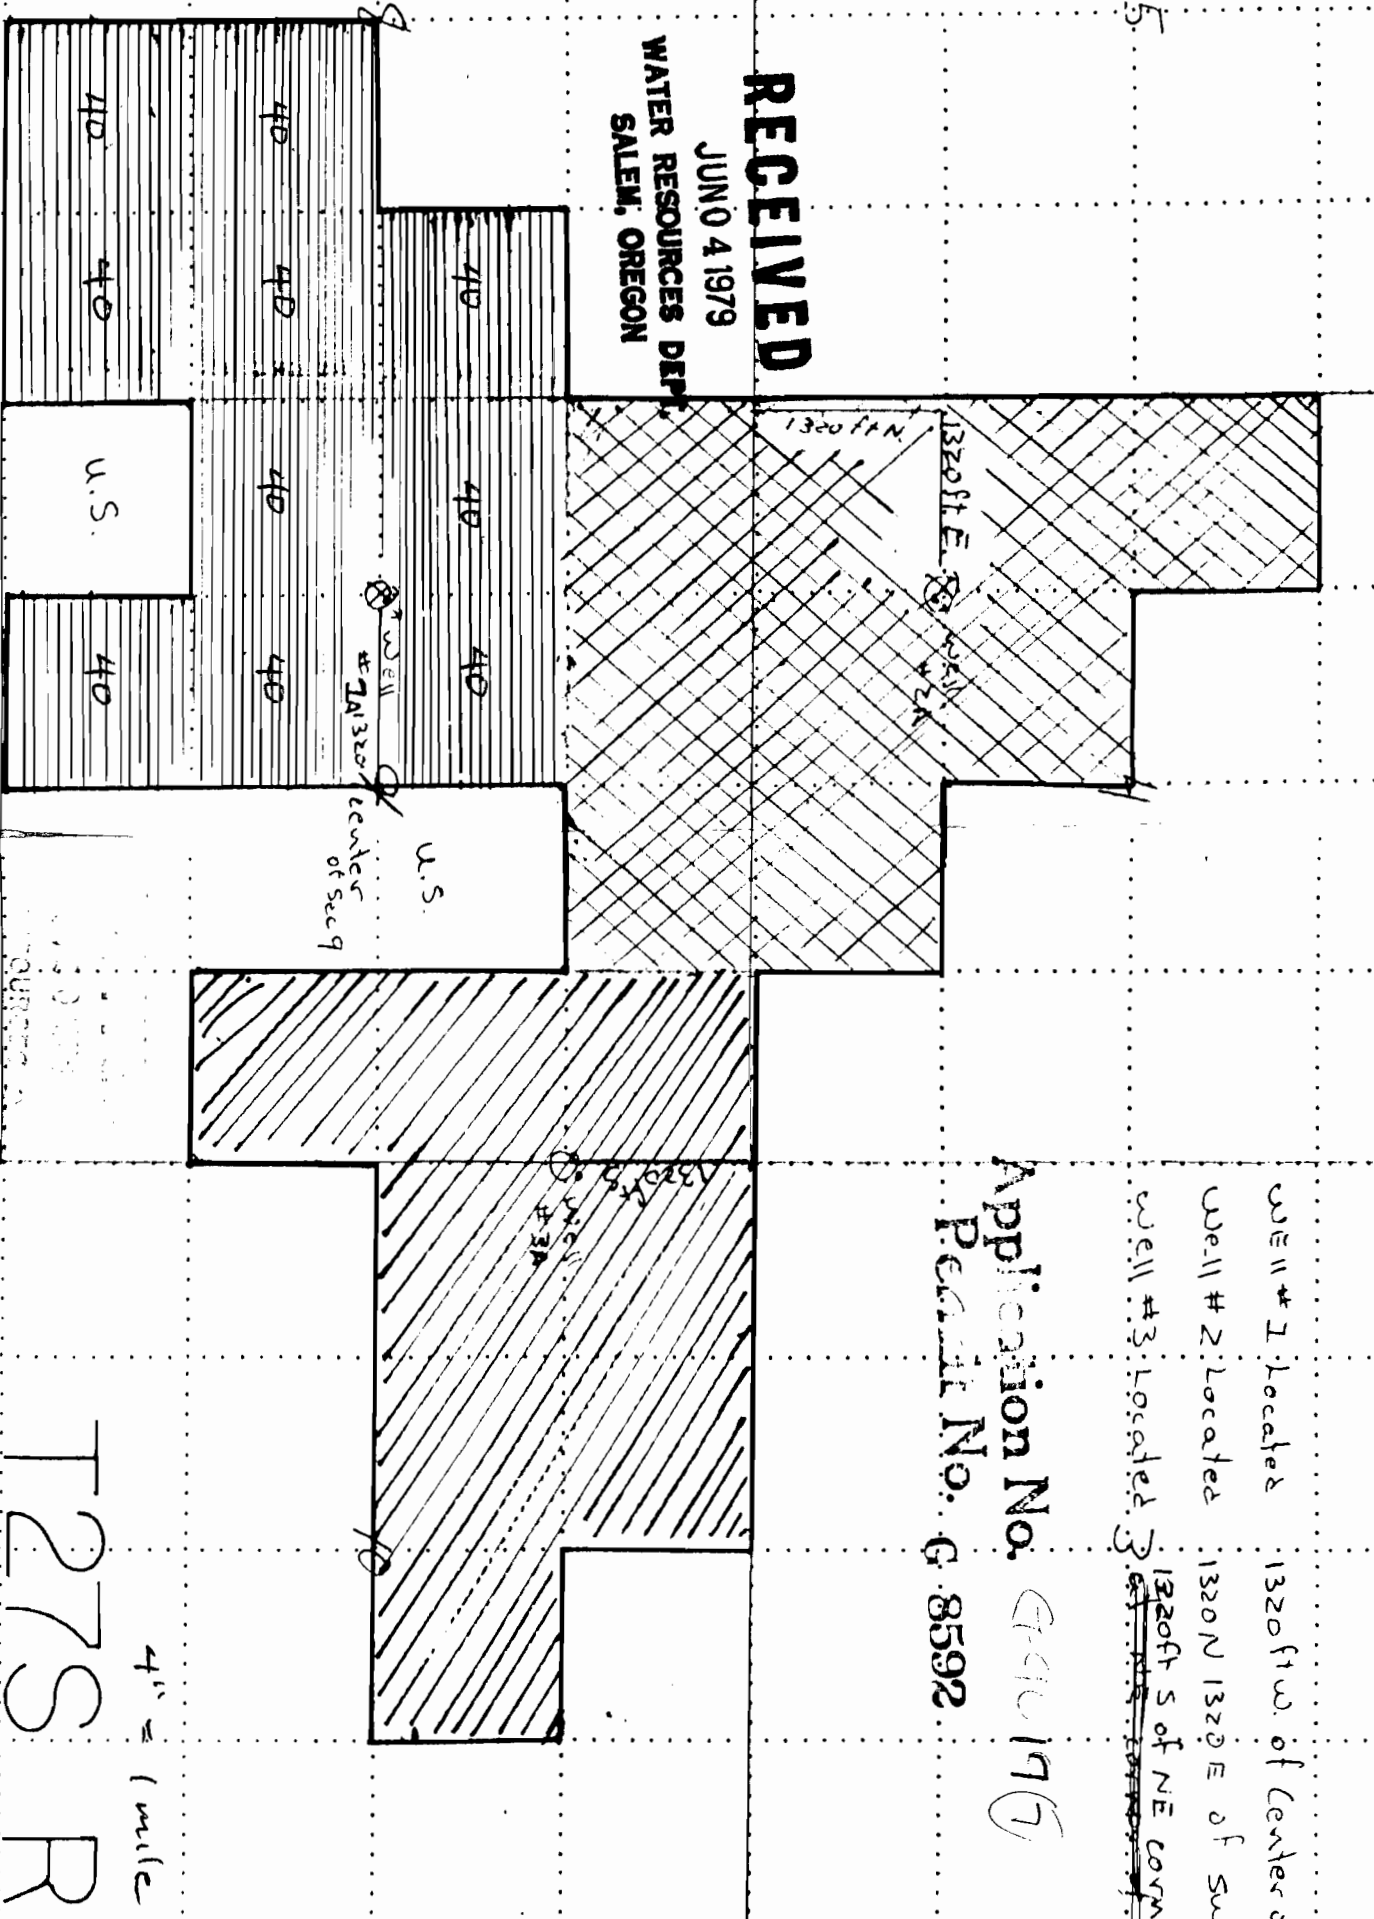


RECEIVED
 JUN 04 1979
 WATER RESOURCES DEPT.
 SALEM, OREGON



Application No. 619017G
 Permit No. G-8592

Well # 1. Located 1320 ft W. of Center of Sec 9 T27S R34E
 Well # 2. Located 1320 N 1320 E of SW corner of Sec 4 T27S R34E
 Well # 3. Located 1320 ft S of NE corner of Sec 9 T27S R34E


4" = 1 mile
 T27S R34E