


Applications:
 T-6966
 G-11992
 AC WRD

PORT OF MORROW
 Water Rights Map for
 Municipal Service Area, POA's & POD's

Morrow County
 Scale 1" = 1320 Ft.

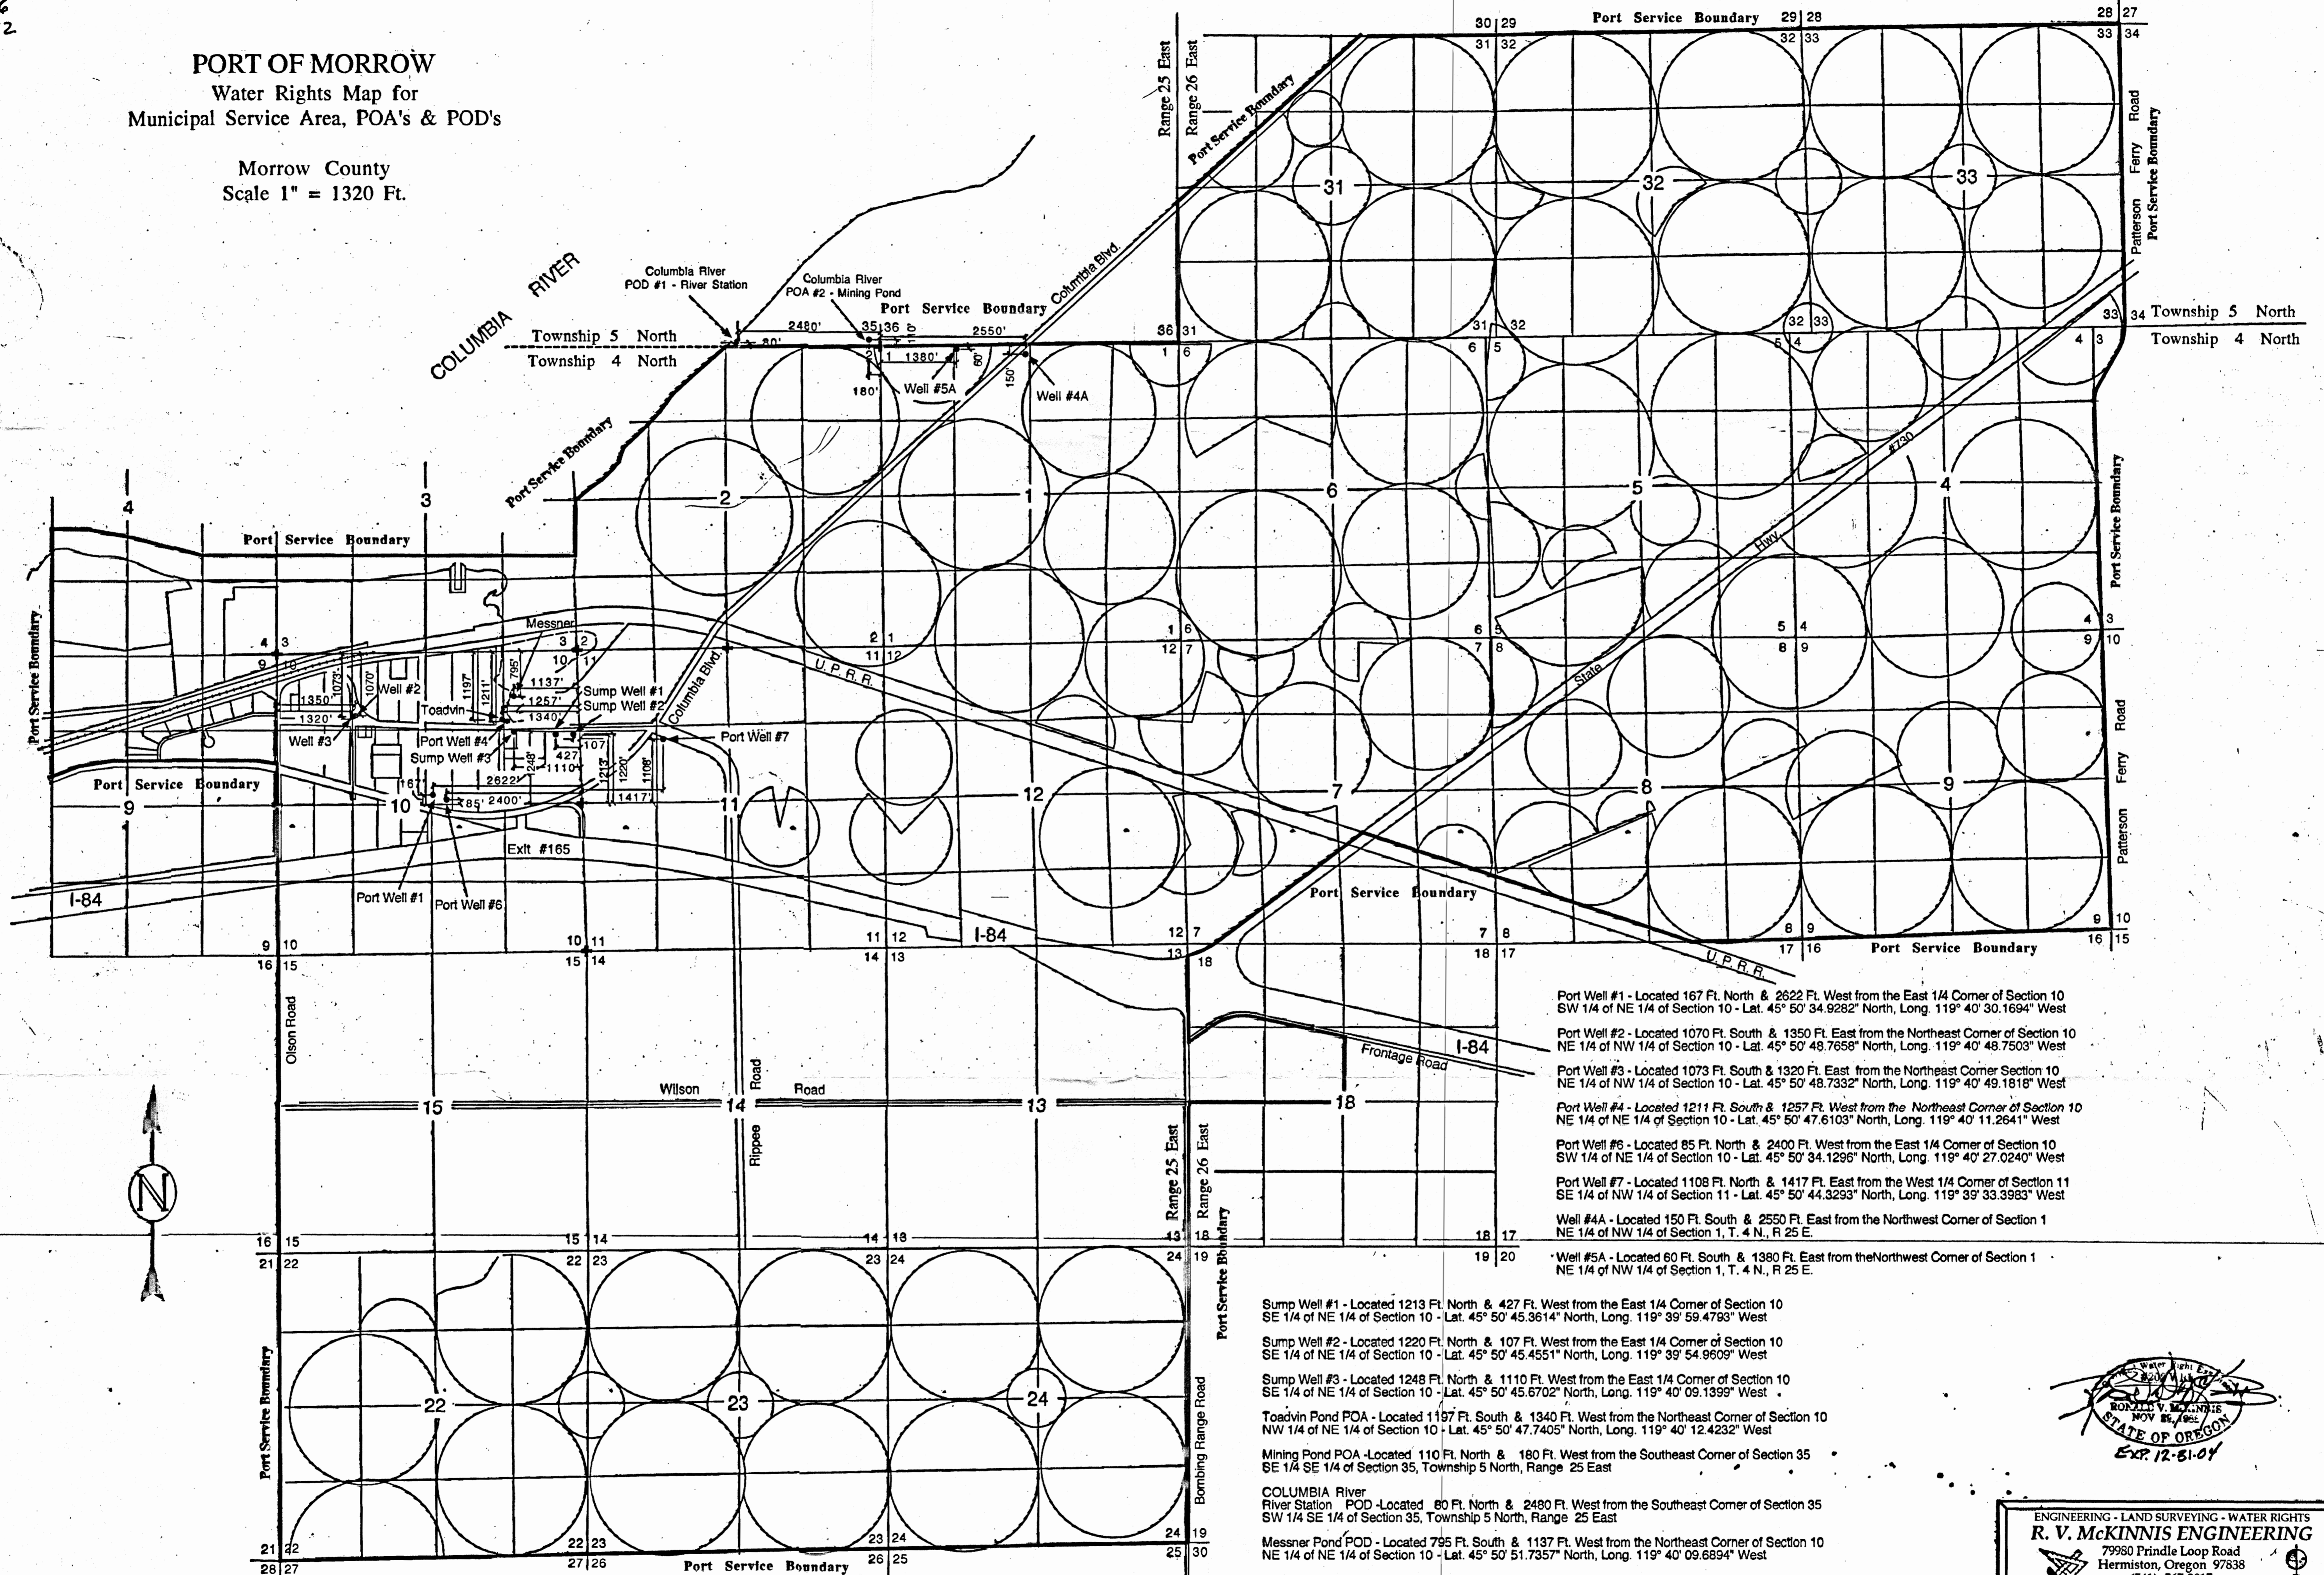

ENGINEERING - LAND SURVEYING - WATER RIGHTS
R. V. MCKINNIS ENGINEERING
 79980 Prindle Loop Road
 Hermiston, Oregon 97838
 (541) 567-2017

Rev. SEPT 09, 2004

COLUMBIA MAP # 0153