


-N-

NW⁴ of Sec 35 T6N R35E WM

RECEIVED
MAY 27 1958
STATE ENGINEER
SALEM, OREGON

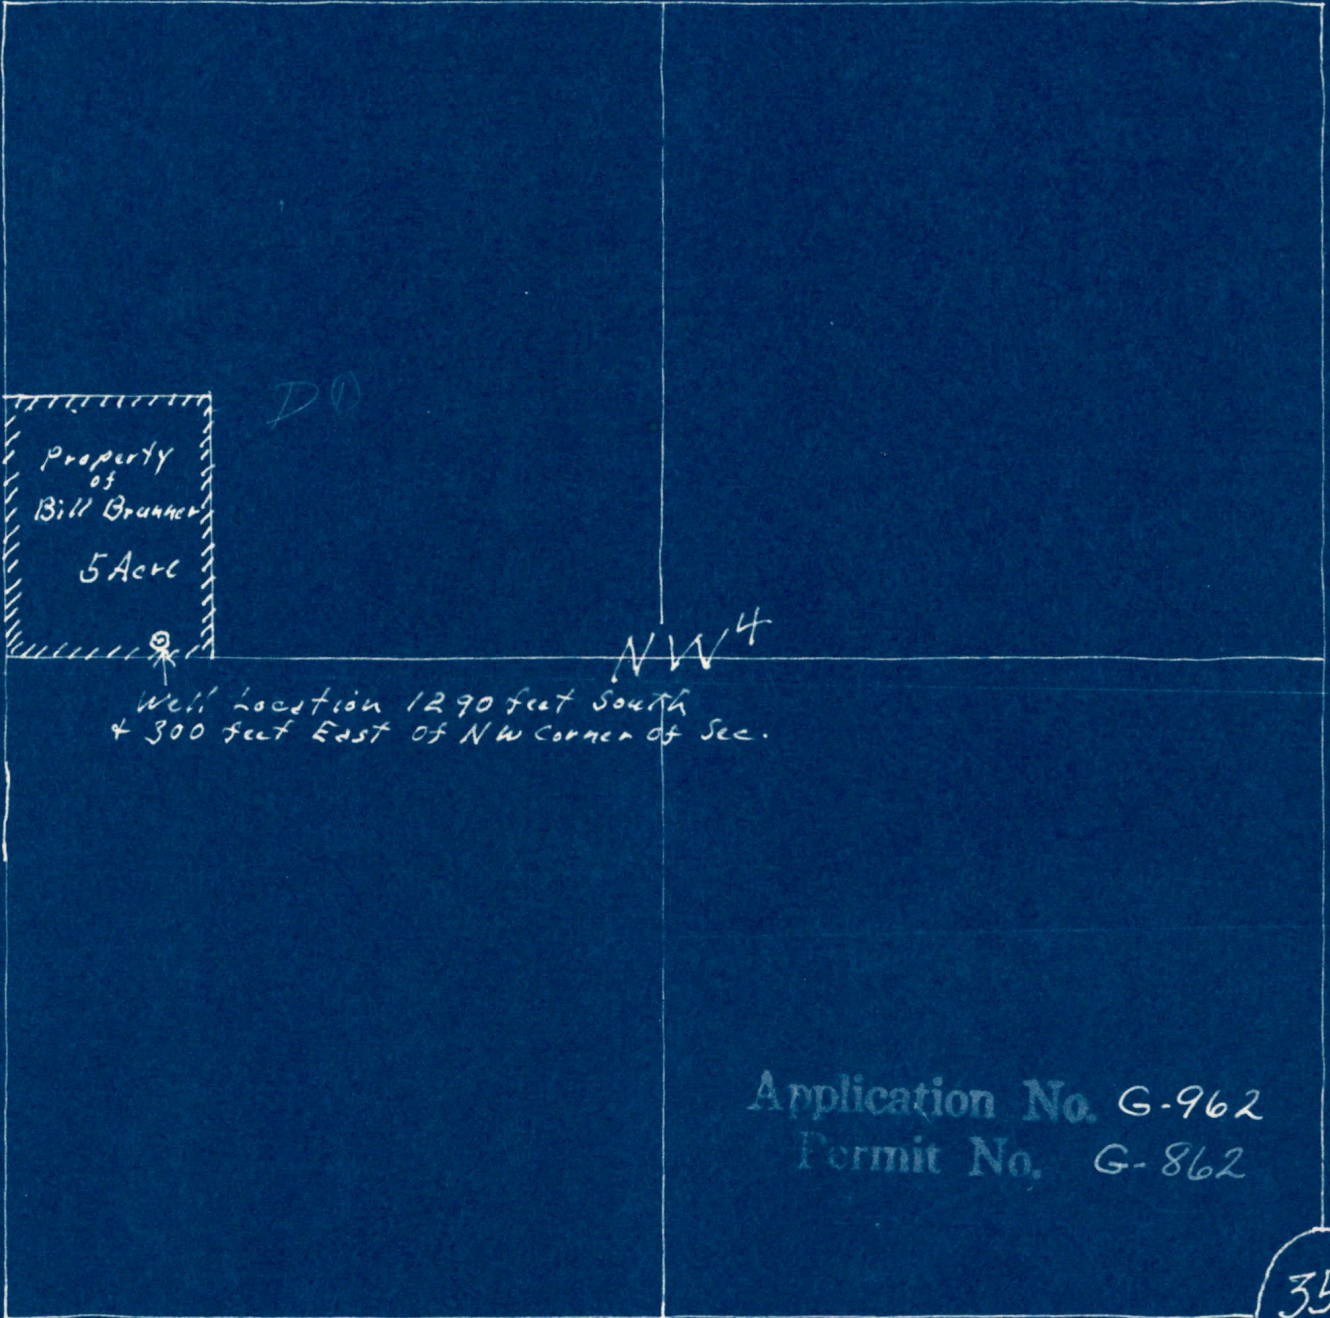

Scale 1" = 400 feet

Map to accompany application of William Brunner
for Well permit April 24, 1958

(EGB)