


RECEIVED

1976

WATER RESOURCES DEPT

T.30S. R.15W. W.M.

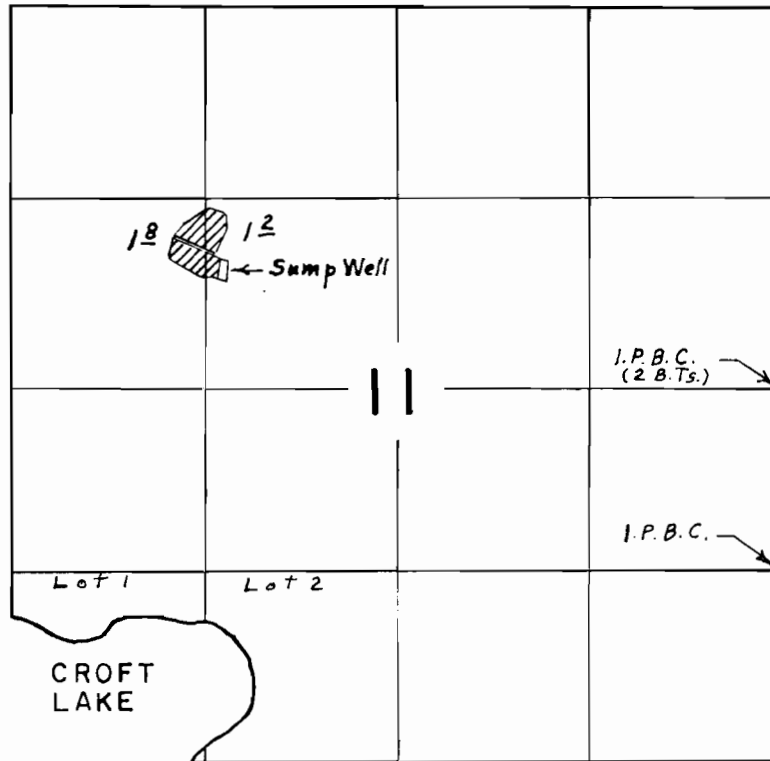

Sump Well located 820' N. & 3830' W. From E. $\frac{1}{4}$ Corner Section 11

Application No. G-5375

Permit No. G 8628

FINAL PROOF SURVEY

UNDER

Application No. G-5375. Permit No. G-4959.
IN NAME OF

NEIL E. & JANET M. DAHLKE

Surveyed Sept. 2., 1976., by L. E. Gould.