


Scale ?
1" = 660'

TGS, R I E W M

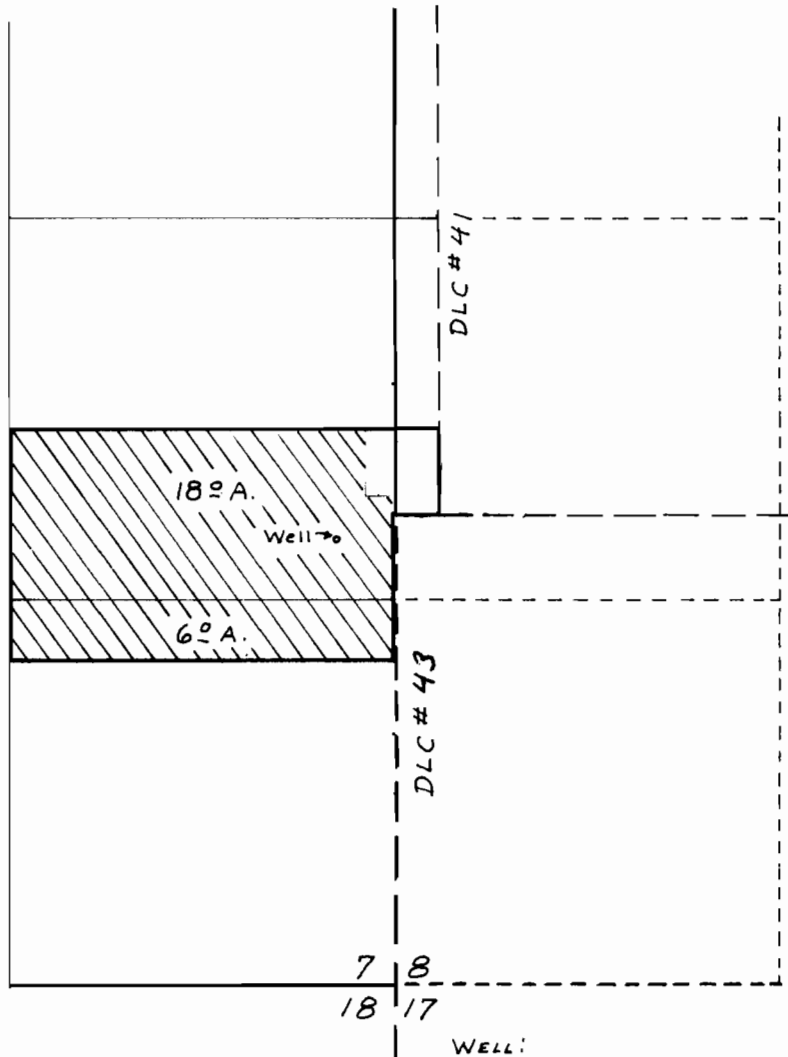

WELL:
80'S ± 200' W
FROM NW COR OF
DLC No. 43

Application No. G-975
Permit No. G-865