


T. 1 N., R. 3 E., W.M.

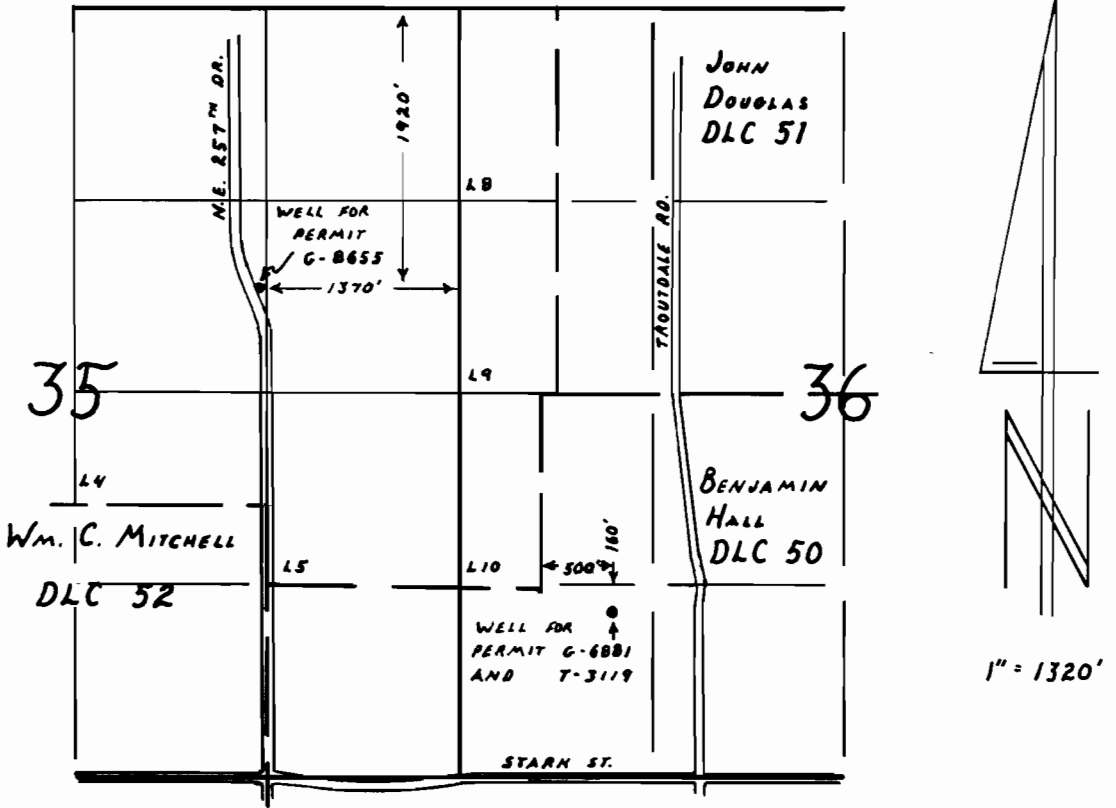

FINAL PROOF SURVEY

UNDER

T-3119

Application No. G-6627, G-9291 Permit No. G-6881, G-8655

IN NAME OF

City of Troutdale

Surveyed August 12, 1993, by R.W. Klassen