



57315
 App. Location No. G-8752
 Survey No. G 8701

T. 1S., R. 24E., W.M.

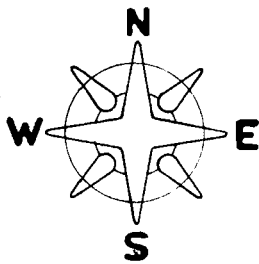

Scale: 4" = 1 mi.

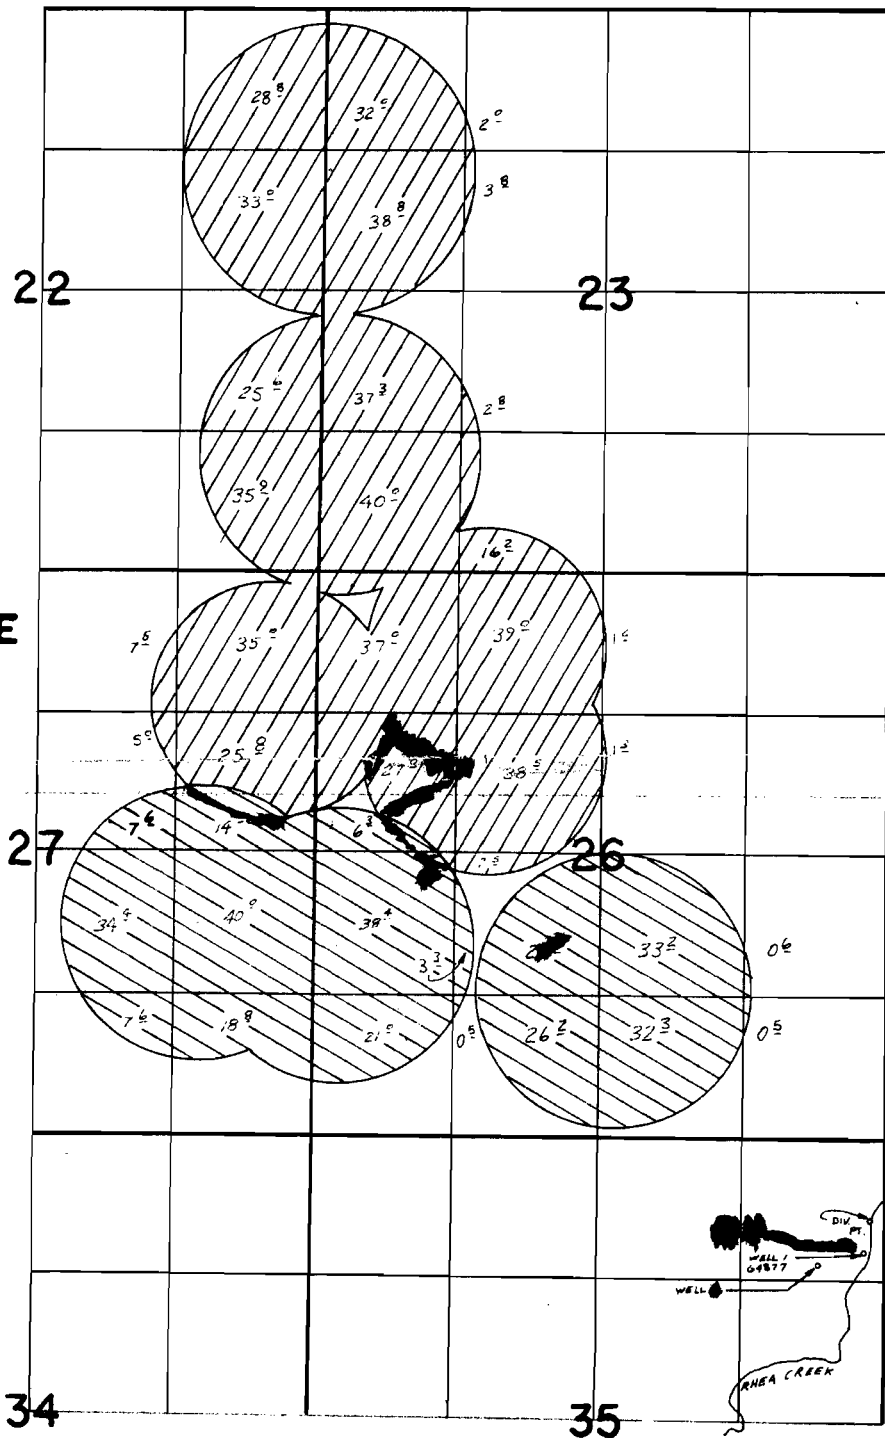

G-4877
 G-6784
 G-4644

WELL 1 LOCATED 1050' S. & 210' W. FROM NE COR SEC 35
 WELL 2 LOCATED 1180' S. & 620' W. FROM NE COR SEC 35
 DIV. PT. LOCATED 760' S. & 190' W. FROM NE COR SEC 35

Primary irrigation from Wells 1 & 2
 Suppl' from Rhea Cr.

Suppl' from Well 2
 Suppl' from Rhea Cr.