


T.34S., R.6W., W.M.

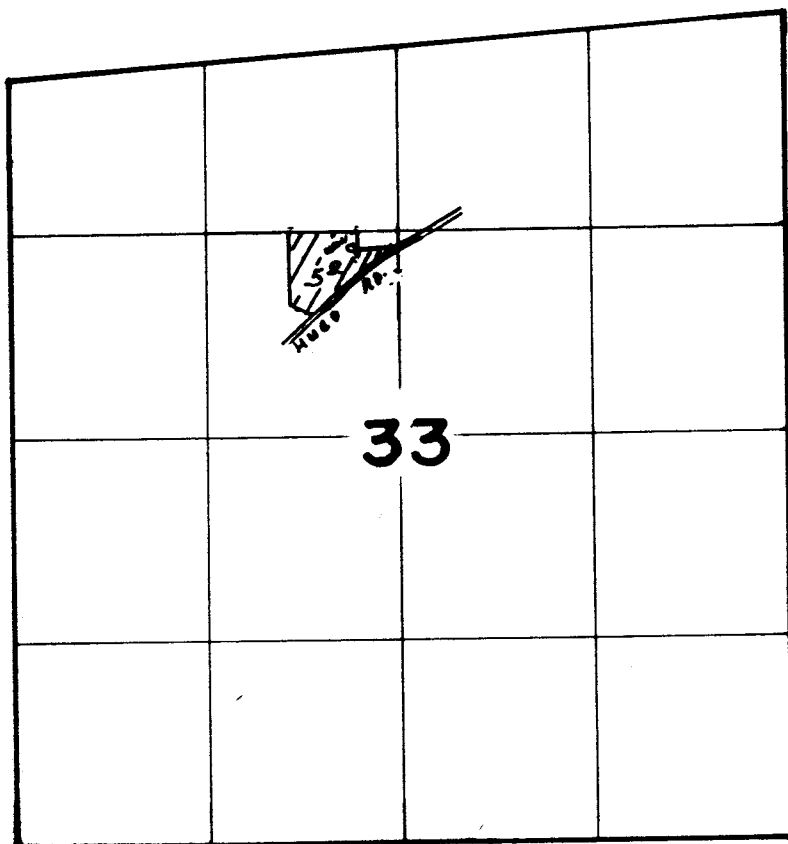

140' 140'S & 260' W FROM N 1/4 COR. SEC 33

SCALE 1"=1320'

**FINAL PROOF SURVEY**  
UNDER

Application No. G.9317... Permit No. G.8.740...  
IN NAME OF

.....LU. & THOMAS...Mc QUINN.....

Surveyed SEPT. 11 1984, by J.R. WOODROOF

41033-179-151L JRW