


T. 35S., R. 6 W., W.M.

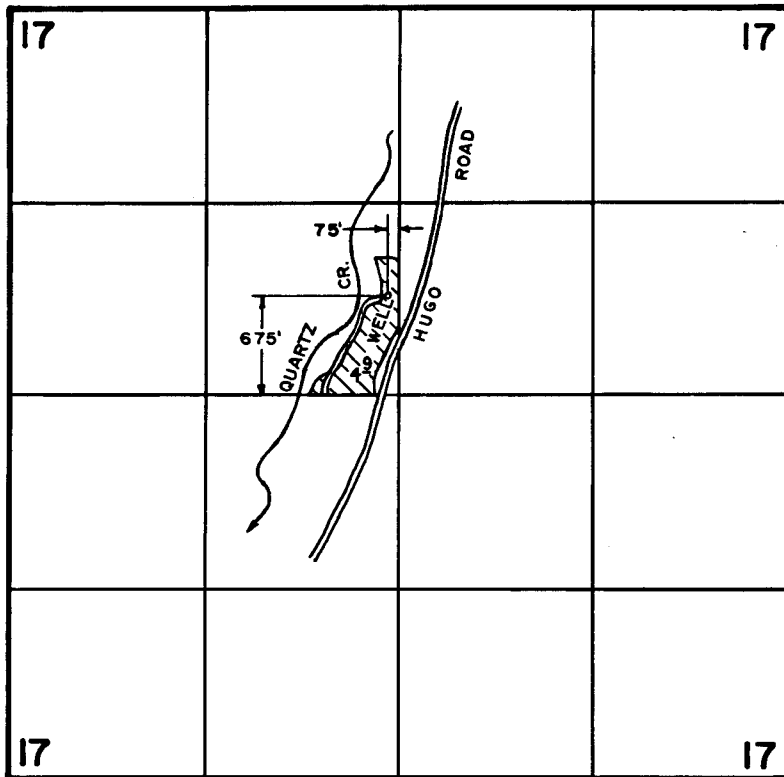

RECEIVED

MAR 30 1987

WM. DIST. 14  
GRANTS PASS, ORE.

**FINAL PROOF SURVEY**

UNDER

Application No. G-9361 Permit No. G-8743  
IN NAME OF

WESLEY BANKS

Surveyed SEPT. 28 1982, by B. SUZIE JAMES

SCALE: 4" = 1 MILE

179-150L TWB