


T. 35 S., R. 6 W., W. M.

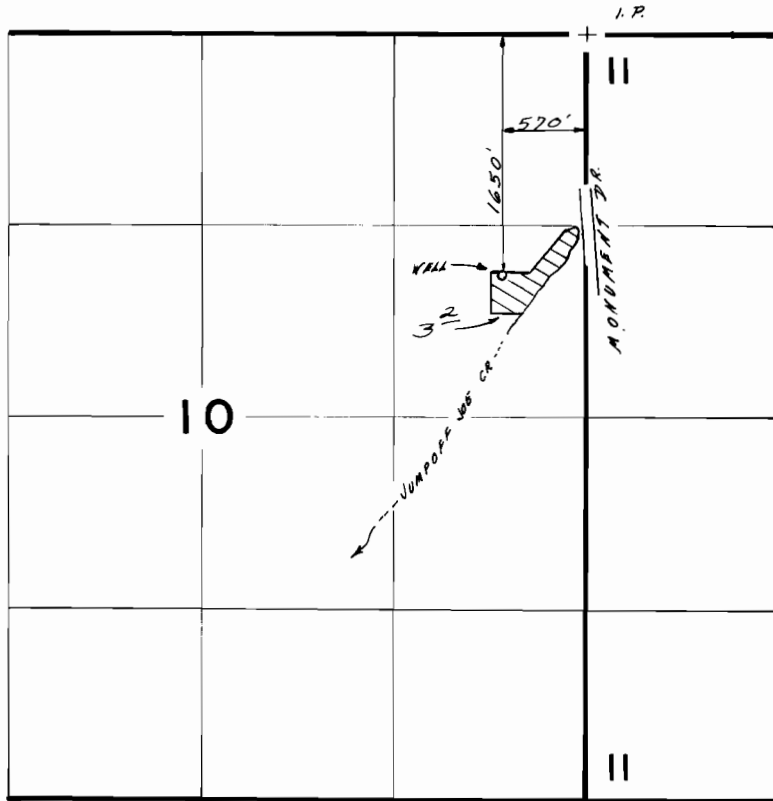

Scale: 1" = 1320'

FINAL PROOF SURVEY
UNDER

Application No. **G-9396** Permit No. **G-8744**
IN NAME OF

..... *R. DEAN BOWLES*

Surveyed **JUL. 16** 19**86**, by **B. S. JAMES**