


Application No. G-9422
Permit No. G 8753

RECEIVED
SEP 27 1979
WATER RESOURCES DEPT.
SALEM, OREGON

T.35. R.3E. SEC 10

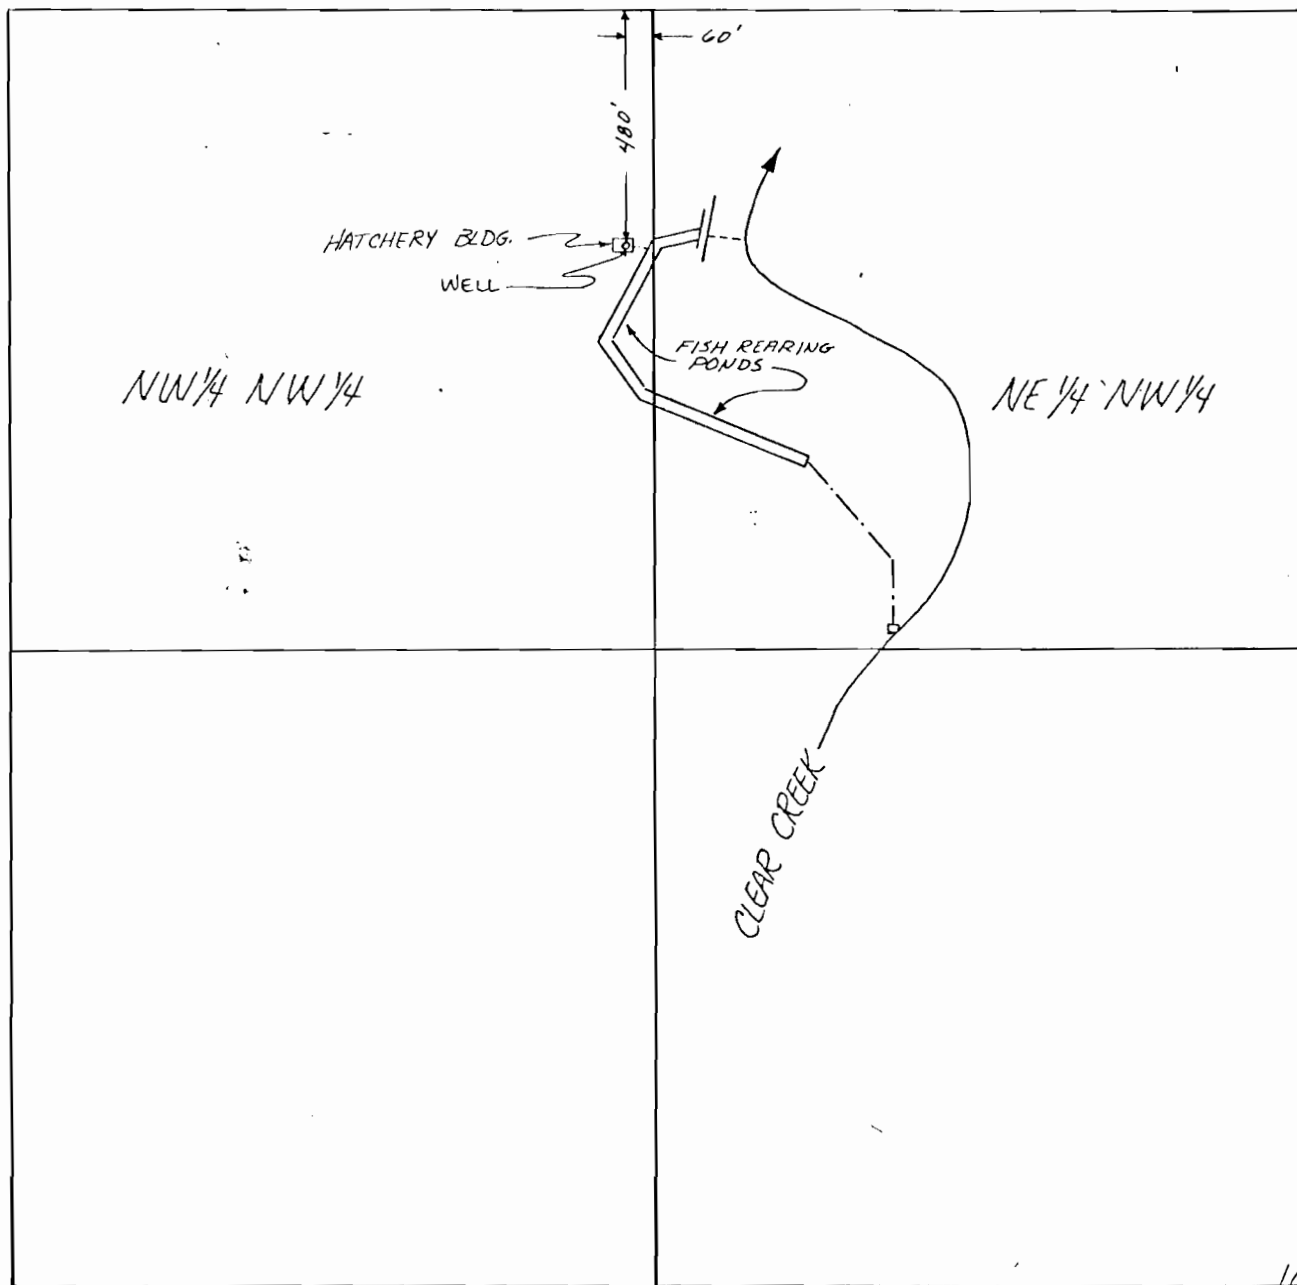

SCALE: 1" = 400'